

Name Jacob Bierenbroodspot

Service No.

Address 25¹/₄ Bedford Street

Lexington, Mass.

Location 2 5¹/₄ Bedford Street

Kind of Pipe Com. June 1, 1948

Size

Size of Main

~~Repair~~ ~~Renewal~~ - New Service

Location

Date	Material	Amount	Total	Date	Amount
Apr. 21, '48	Labor	43 68		April 20 48	20 00
22	"	12 45	56 13	June 12 '48	36 32
	10% Overhead		5 61		116 32
	11 ¹ / ₄ ' - 6" Sewer Pipe @.26		37 14		
	Joint Compound		8 64		
	Littlefield Shovel 1 hr. @7.00		7 00		
	Trucking 2 hrs. @.75		1 50		
			116 32		
	Labor				

TOWN OF LEXINGTON—DEPT. OF PUBLIC WORKS
SEWER DIVISION

DATE

NO.

The undersigned applies for the construction of a particular sewer connecting No.
Street and hereby agrees to comply with the Rules and Regulations governing the construction and use of Particular
Sewers, as now or at any future time established by the Board of Selectmen.


Am't of estimate \$.

Am't Paid \$.

..... Owner

Sketch of Service Here

254

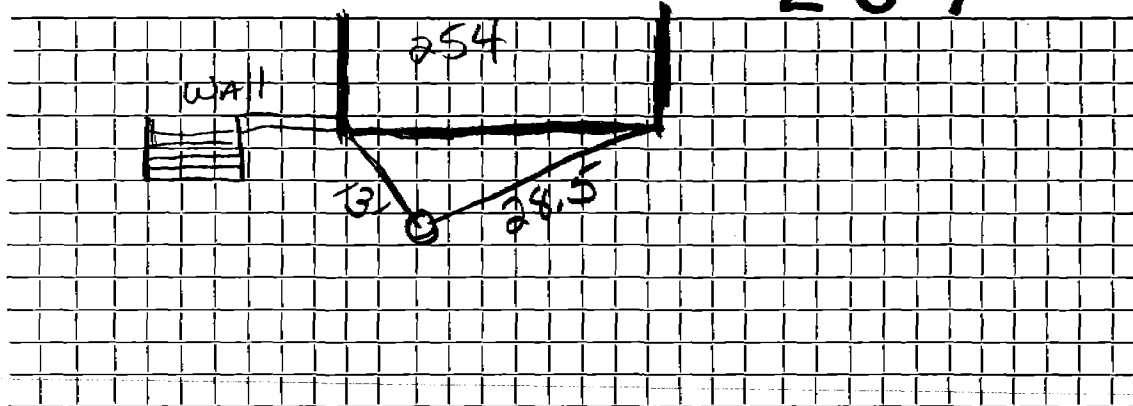

Connection made in ... CLEAN out in BACK Street.

Work completed 19..

Remarks:

of house SERVICE
goes out back to ENSEMENT