

Name Lawrence K. Pious

Service No. 2

Address 255 Bedford Street

Location

Kind of Pipe

Size

Size of Main

~~Repair~~—Renewal—~~XXXXXX~~ New Service ~~XXXXXXXX~~

W. O. # 509

Location

MAY 29 1973

Date	Material	Amount	Total	Date	Amount
3/9/73	Labor	132 00		2-12-73	Deposit 700 00
3/12/73	"	66 00	198 00	5-29-73	Refund 333 25
	10% O.H.		19 80		377 25
30'	Transite 6" @ .90		27 00		
7	5'x6" Trans w/cplg.		28 06		
1	1 1/2" Elbow		3 95		
1	1 1/2" Sweep		4 65		
1	2 1/2" Sweep		6 83		
1	6" x 6" Wye		9 37		
1	2' x 6" Nipple		3 16		
1	Donut		2 65		
1	6" Coupling		1 78		
2	Ton cold patch 8.00		16 00		
2	Yds. loam 3.50		7 00		
10	Lbs. Seed 1.10		11 00		
2	Hrs. Truck 3.00		6 00		
2	" P.U. truck 1.50		3 00		
3	" Shovel 6.50		19 50		
2	" Loader 5.00		10 00		
			377 75		
				2-3-73	Roots 40' from house
				1-25-73	Roots in several joints


DATE _____

TOWN OF LEXINGTON — BOARD OF PUBLIC WORKS

SEWER DIVISION

Sketch of Service Here

255

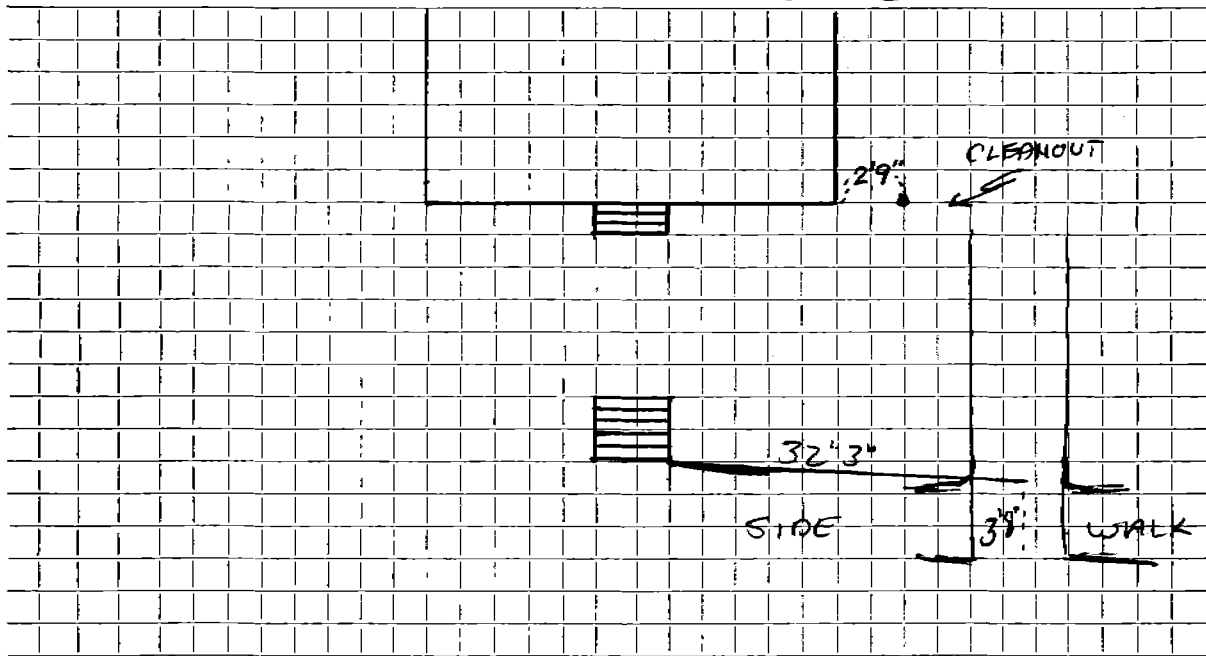

Connection made in Street. Work completed

Remarks:

.....

.....

.....

The layout and location of this sewer service connection is in accordance with my request and instructions to the Department of Public Works for the Town of Lexington.

I appreciate that there are changes in alignment of pipe underground without accessible cleanouts, and I further assume all responsibility and any costs that may be involved due to stoppages.

Lawrence P. Pious
Name

255 Bedford Street
Address