


DATE OCT 31, 1984

TOWN OF LEXINGTON — BOARD OF PUBLIC WORKS
SEWER DIVISION

Sketch of Service Here

257

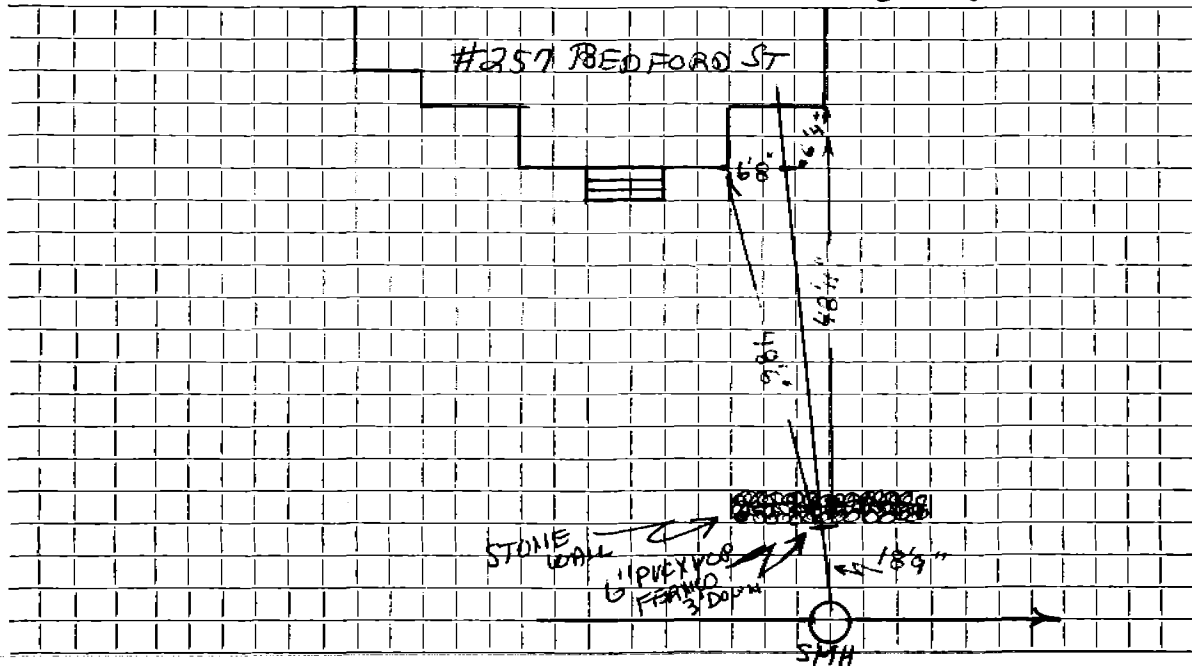

Connection made in BEDFORD ST Street. Work completed

Remarks:

Repair made 5.23.00 by McCoet