

Name Alfred Emerson

Service No. 144 (1952)

Address 258 Bedford Street
Lexington

Location

Kind of Pipe

Size

Size of Main

~~Repair~~ ~~Renewal~~ New Service

COM. 6-8-53

Location

Date	Material	Amount	Total	Date	Amount
5/19/53	Labor	73 46		9-16-52	150 00
	10% overhead	7 35	80 81	6-8-53	35 25
	44' - 6" sewer pipe @ .342		15 05		114 75
	joint compound		2 64		
	1 hr. #37 compressor		1 75	5/19/53	22 04
	2 hrs. trucking @ .75		1 50	8' - 6" sewer pipe @ .342	2 75
	patching 13 x 3		13 00	joint compound	48
			114 75	1 hr. #37 compressor	1 75
				1 hr. trucking	75
				patching 8 x 3	8 00
				Renewal W.P. #1178	35 77
				4/3/85	27' 6" PVC Pipe
				1	6" PVC to 6" Clay Adapter
	Labor			1	6" PVC to PVC 6" Coupling
				5-27-80	Roots about 29' in from manhole (at main)
				12-7-84	Roots 15'-24' in from M.H. in street

TOWN OF LEXINGTON—DEPT. OF PUBLIC WORKS
SEWER DIVISION

DATE.....

NO.....


The undersigned applies for the construction of a particular sewer connecting No.....
Street and hereby agrees to comply with the Rules and Regulations governing the construction and use of Particular
Sewers, as now or at any future time established by the Board of Selectmen.

Am't of estimate \$.....

Am't Paid \$.....

..... Owner

Sketch of Service Here **258**

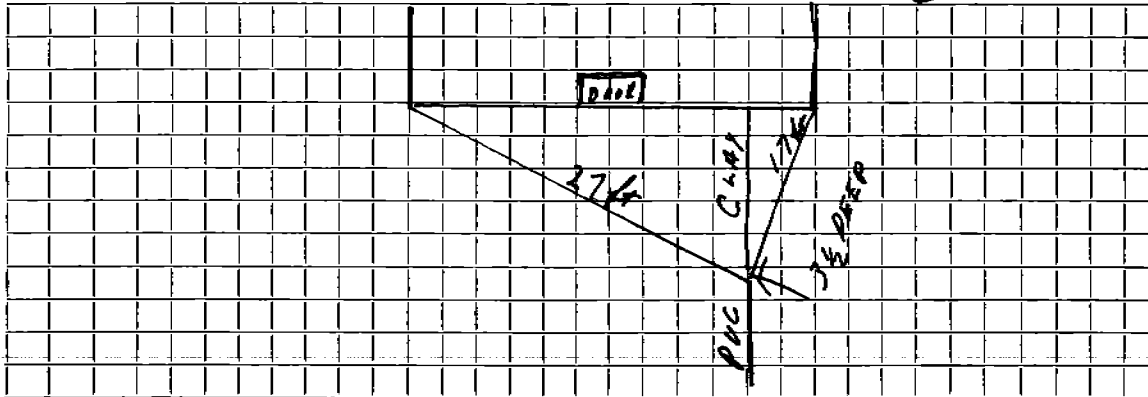

Connection made in..... Street.

Work completed.....19..

Remarks: