

Name *Martin Saradjian*

Service No.

Address *259 Bedford Street*

Location

Kind of Pipe

Size

Size of Main

Repair—~~Renewal~~—New Service *Valeri #3853*


Location

Date	Material	Amount	Total	Date	Amount
<i>10/25/83</i>	<i>33' x 6" P.V.C.</i>				
	<i>1 Donut</i>				
	<i>1 P.V.C. to Clay Fernco Adaptor</i>				
<i>12-15-82</i>	<i>46' 6" Pipe</i>				
	<i>1 6" Elbow</i>				
				<i>3-28-83</i>	<i>ROOTS 32' OUT</i>

DATE _____

TOWN OF LEXINGTON — BOARD OF PUBLIC WORKS
SEWER DIVISION

Sketch of Service Here

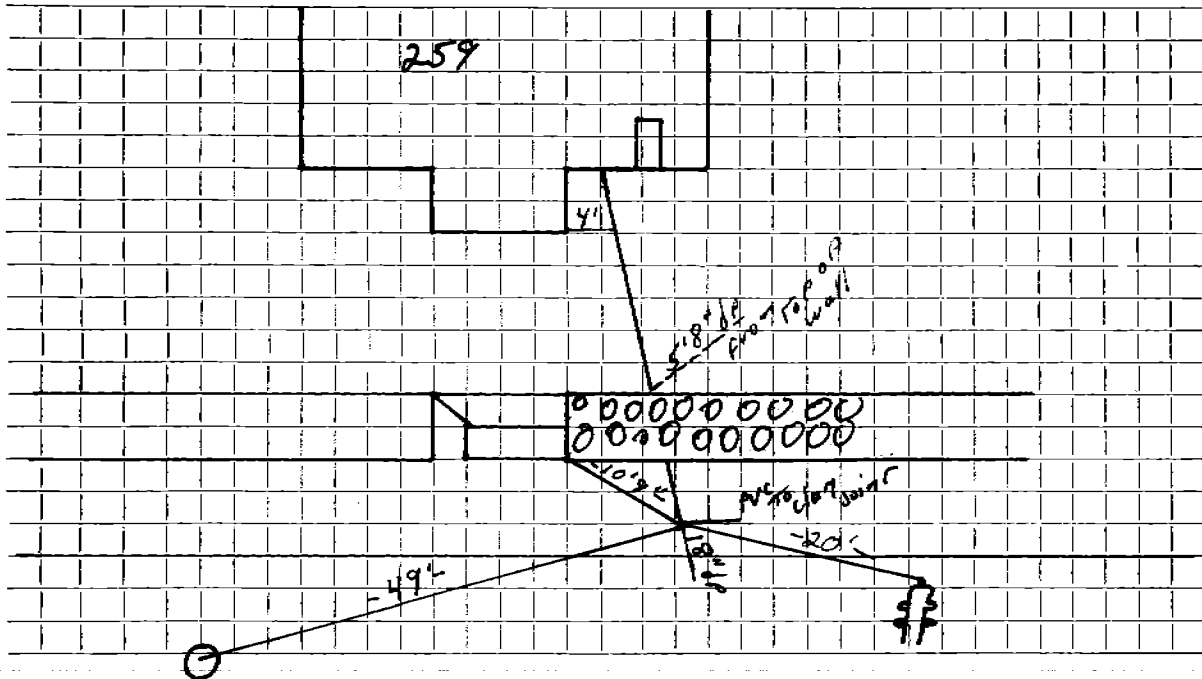

Connection made in Street. Work completed

Remarks:
Repair \$23.00 by McCort