

Name A. David Bjorkgren

Service No. 66

Address 265 Bedford Street

Location 265 Bedford Street

Kind of Pipe

Size

Size of Main

~~REPAIR EXISTING~~ New Service

Location

Date		Material	Amount	Total	Date		Amount
Nov. 5,	47	Labor	24 45	24 45	Nov 3 '47	Deposited	86 00
		10% Overhead		2 45	Dec. 31 '47	Refunded	17 96
		52' - 6" Sewer Pipe @.26		13 52			67 04
		Joint Compound		3 12			
		Hired Shovel 1 hr. @ 7 00		7 00			
		Trucking 2 hrs. @.75		1 50			
		Patching 15 x 3		15 00			
1-12-	66	Renewal		67 04			
		30' 6" Transite					
		2 Adapters					
		Labor					
					10/9/13	Drain Double	
					4/3/65	STORAGE (P)	
					1/12/66	ROOTS	

TOWN OF LEXINGTON—DEPT. OF PUBLIC WORKS  
**SEWER DIVISION**

DATE .....

NO. ....


The undersigned applies for the construction of a particular sewer connecting No. ....  
Street and hereby agrees to comply with the Rules and Regulations governing the construction and use of Particular  
Sewers, as now or at any future time established by the Board of Selectmen.

Am't of estimate \$.....

Am't Paid \$.....

..... Owner

Sketch of Service Here **265**

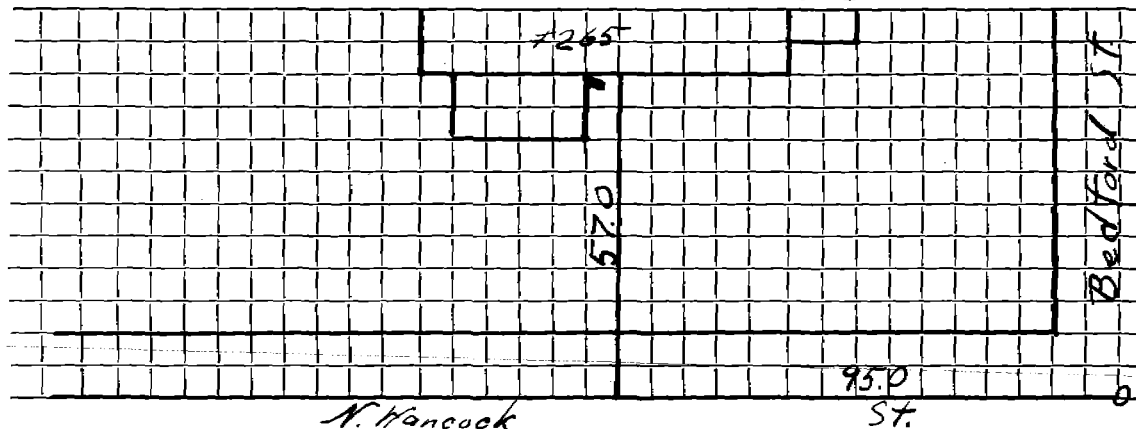

Connection made in ..... Street.

Work completed ..... 19..

Remarks: