


DATE _____

TOWN OF LEXINGTON — BOARD OF PUBLIC WORKS

SEWER DIVISION

Sketch of Service Here **282**

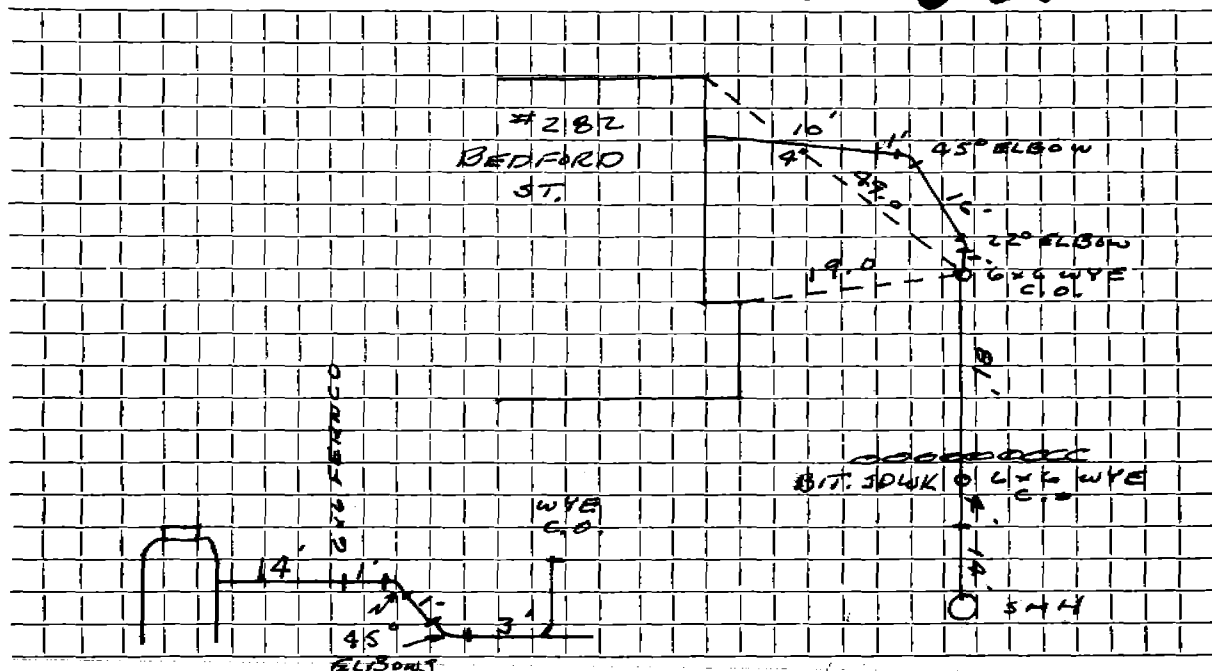

Connection made in BEDFORD Street. Work completed

Remarks: WYE CLEANOUT IN SDWK. RE: SERV. UNDER TEL. CABLE

.....
.....