

Name Stanley Phalen

Service No. 26

Address 286 Bedford Street

Lexington, Mass.

Location 286 Bedford Street

Kind of Pipe

Size

Size of Main

~~REPAIR~~ New Service Com. 7-3-50

Location

Date	Material	Amount	Total	Date	Amount
June 14, '50	Labor	34 50		May 22 '50	250 00
June 15, '50	Labor	<u>41 17</u>	75 67	July 20 '50	<del>8 2</del>
	10% Overhead		7 57		241 00
	104' - 6" Sewer Pipe @.28		29 12		
	Joint Compound		6 24		
	Dynamite 1 lb. @.215		22		
	Exploders 2 @.117		23		
	Compressor 4 hrs. @ 1.75		7 00		
	Littlefield Shovel 14 hrs. @7.00		98 00		
	Trucking 4 hrs. @.75		3 00		
	Patching 14 x 3		<u>14 00</u>		
			241 05		
	Labor				

**TOWN OF LEXINGTON—DEPT. OF PUBLIC WORKS  
SEWER DIVISION**

DATE .....

NO. ....


The undersigned applies for the construction of a particular sewer connecting No. ....  
Street and hereby agrees to comply with the Rules and Regulations governing the construction and use of Particular  
Sewers, as now or at any future time established by the Board of Selectmen.

Am't of estimate \$ . . . . .

Am't Paid \$ . . . . .

..... Owner

**Sketch of Service Here**

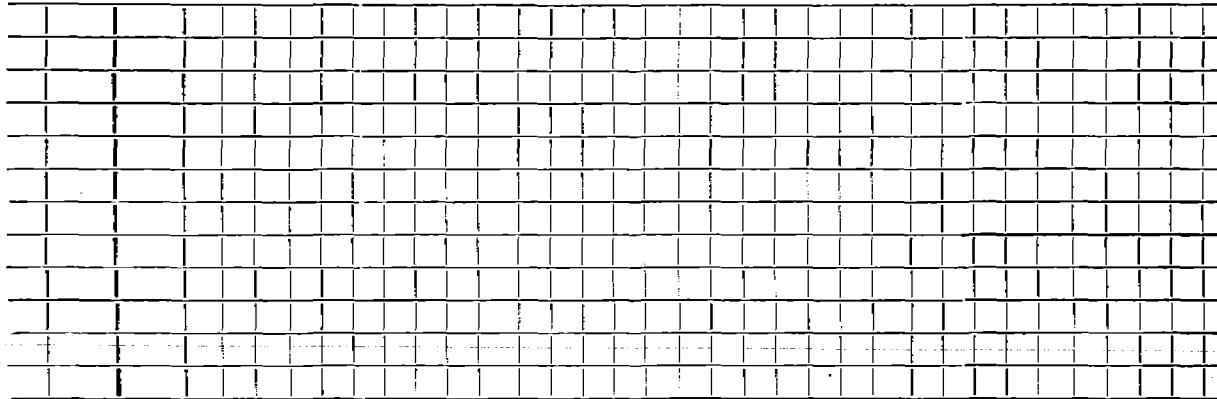

Connection made in ..... Street.

Work completed ..... 19..

Remarks: