

Name Chester W. Johnson

Service No. 7

Address 292 Bedford Street

Location

Kind of Pipe

Size

Size of Main

~~Repair~~ ~~Renewal~~ New Service

Location *Comm 2-5-60*

Date	Material	Amount	Total	Date	Amount
5-11-60	Labor	15.22		3-16-61	35.00
5-12-60	"	65.95		7-5-60	12.37
5-13-60	"	25.73	106.90		226.29
	10' C.H.	10.69	117.59		
	120' 6" Transite Pipe @ .78		93.60		
	1 11 1/4" Transite Bend		5.10	4-30-01	
	10 x 3 Patch		10.00		
			226.29		


Service Blocked - roots in M.H CLEAN out in sidewalk - SERVICE CAN BE flushed with myer

DATE _____

TOWN OF LEXINGTON — BOARD OF PUBLIC WORKS

SEWER DIVISION

Sketch of Service Here

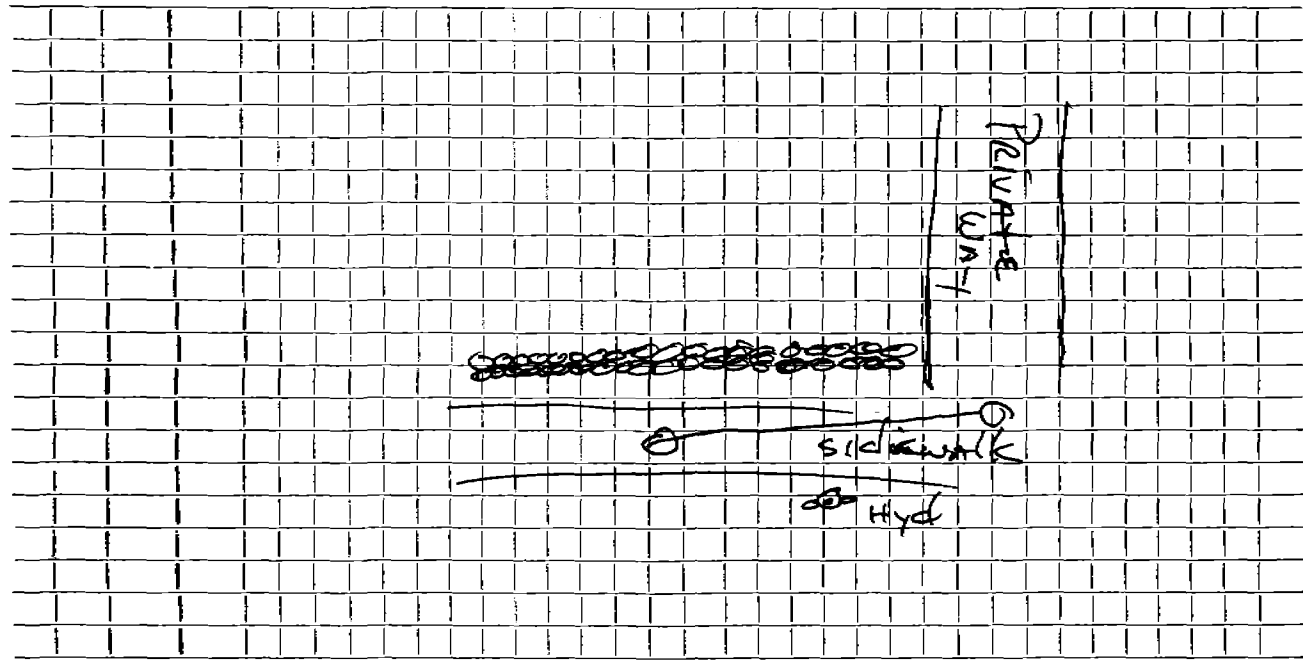

Connection made in Street. Work completed

Remarks:
.....
.....