

Name

Service No. 37

Address 3 & 5 Bedford St.

Location 3 & 5 Bedford Street

Kind of Pipe

Size

Size of Main

Repair—Renewal—New Service

Location

Date	Material	Amount	Total	Date	Amount
	Labor				

TOWN OF LEXINGTON—BOARD OF PUBLIC WORKS
SEWER DIVISION

DATE _____

NO. _____

The undersigned applies for the construction of a particular sewer connecting No. 345 Bedford St. Street and hereby agrees to comply with the Rules and Regulations governing the construction and use of Particular Sewers, as now or at any future time established by the Board of Selectmen.


Am't. of Estimate \$ _____

Am't. Paid \$ _____

Owner

Sketch of Service Here

345

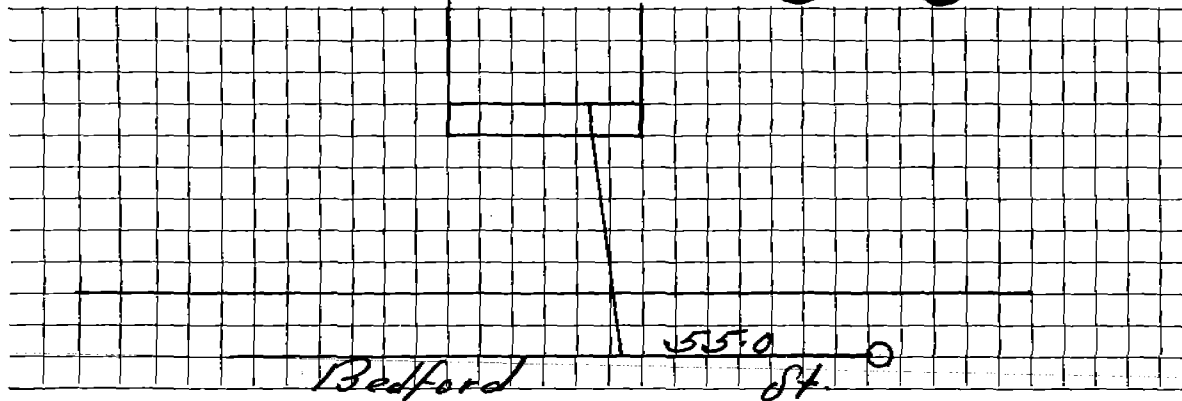

Connection made in _____ Street.

Work completed _____ 19

Remarks: