


TOWN OF LEXINGTON — BOARD OF PUBLIC WORKS

SEWER DIVISION

DATE 5/20/21

Sketch of Service Here

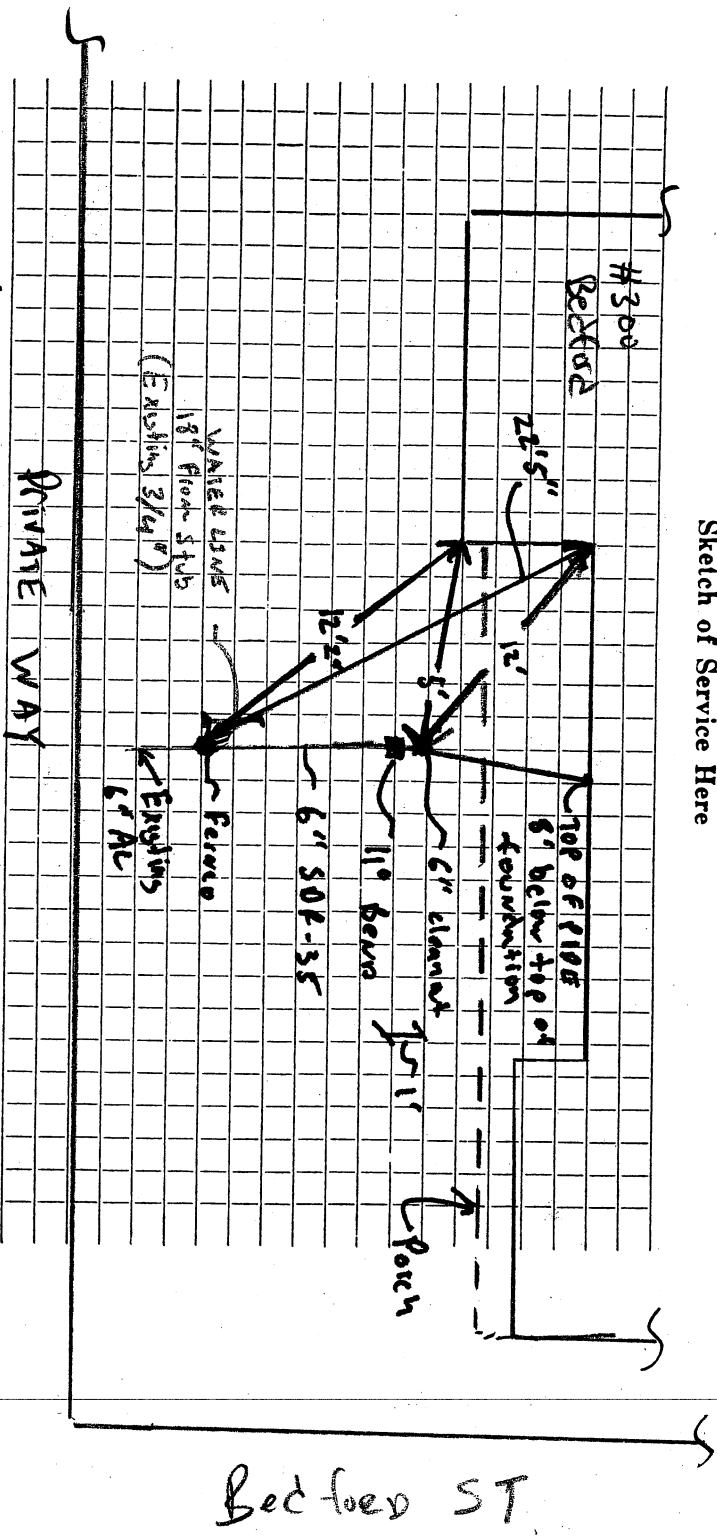

Connection made in Existing AC Pipe Street Private Way Work completed Renewal

Remarks: that enters into the private way





DATE \_\_\_\_\_

**TOWN OF LEXINGTON — BOARD OF PUBLIC WORKS**  
**SEWER DIVISION**

Sketch of Service Here

A large grid of graph paper, consisting of 20 columns and 20 rows, intended for sketching service details.

Connection made in ..... Street. Work completed .....

Remarks: .....  
.....  
.....

