




DATE \_\_\_\_\_

TOWN OF LEXINGTON — BOARD OF PUBLIC WORKS  
SEWER DIVISION

303

Sketch of Service Here

NOW #303 BEDFORD ST.  
S.S. FOR VAC. LOT.  
7' DEEP

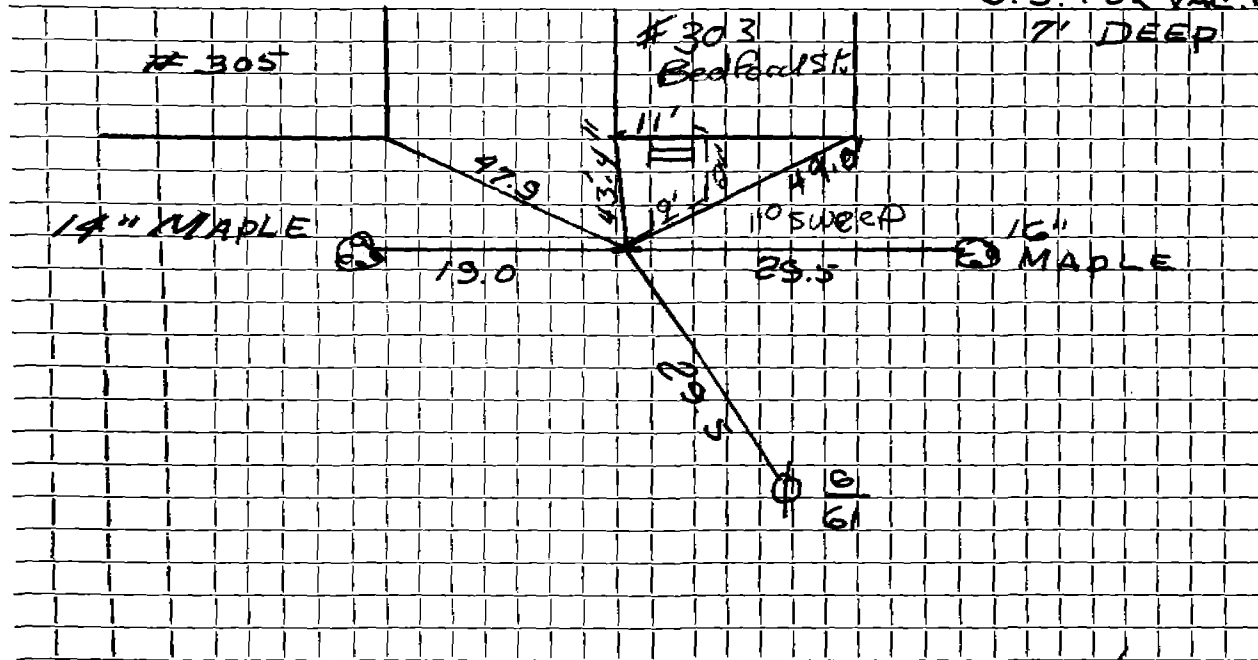

Connection made in #303 Bedford St Street.

Work completed 7/9/74

Remarks: .....