

Name Peter Whittmore

Service No. 11

Address 307 Bedford Street

Lexington, Mass.

Location 307 Bedford Street

Kind of Pipe

Size

Size of Main

~~Repair & Renewal~~ - New Service

Com. 5-2-49

Location

Date	Material	Amount	Total	Date	Amount
Apr. 11, '49	Labor	22 75		<i>Mar 31, '49 Deposited</i>	200 00
Apr. 12, '49	Labor	54 27			<i>May 5, '49 Refunded</i>
Apr. 13, '49	Labor	51 33	128 35		183 94
	10% Overhead		12 84		
	60' - 6" Sewer Pipe @.265		15 90		
	Joint Compound		3 60		
	Shovel 1 hr. @7.00		7 00		
	#36 Compressor 1 hr.		2 75		
	Trucking 2 hrs. @.75		1 50		
	Patching 12 x 3		12 00		
9-30-77	Renewal		183 94		
	30' 6" Transite				
	1 4 ^{hr} Labor DONUT				

TOWN OF LEXINGTON—DEPT. OF PUBLIC WORKS
SEWER DIVISION

DATE

NO.


The undersigned applies for the construction of a particular sewer connecting No.
Street and hereby agrees to comply with the Rules and Regulations governing the construction and use of Particular
Sewers, as now or at any future time established by the Board of Selectmen.

Am't of estimate \$.....

Am't Paid \$.....

..... Owner

Sketch of Service Here **307**

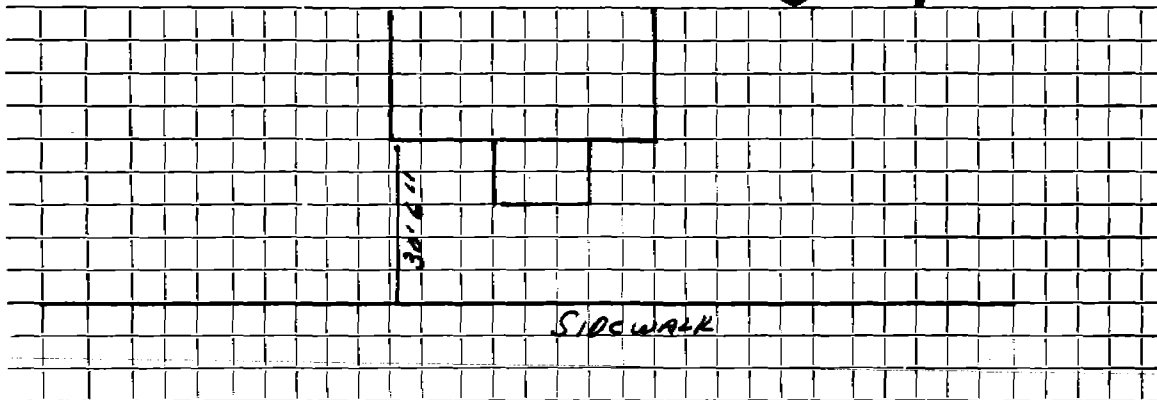

Connection made in Street.

Work completed 19..

Remarks: