

Name LOUDANI

Service No.

Address 311 BEDFORD ST

Location

Kind of Pipe

Size

Size of Main

Repair—Renewal—New Service

REPAIR - ROCKWELL CONSTRUCTION - #824

Location

Date	Material	Amount	Total	Date	Amount
------	----------	--------	-------	------	--------

6/25 96	26' OF 6" PVC				
---------	---------------	--	--	--	--

4-12-49	Original				
---------	----------	--	--	--	--

62'	6" Sewer Pipe				
-----	---------------	--	--	--	--

				10-16-77	Roots 10' OUT
--	--	--	--	----------	---------------


DATE 6/25/96

TOWN OF LEXINGTON — BOARD OF PUBLIC WORKS

SEWER DIVISION

Sketch of Service Here

311

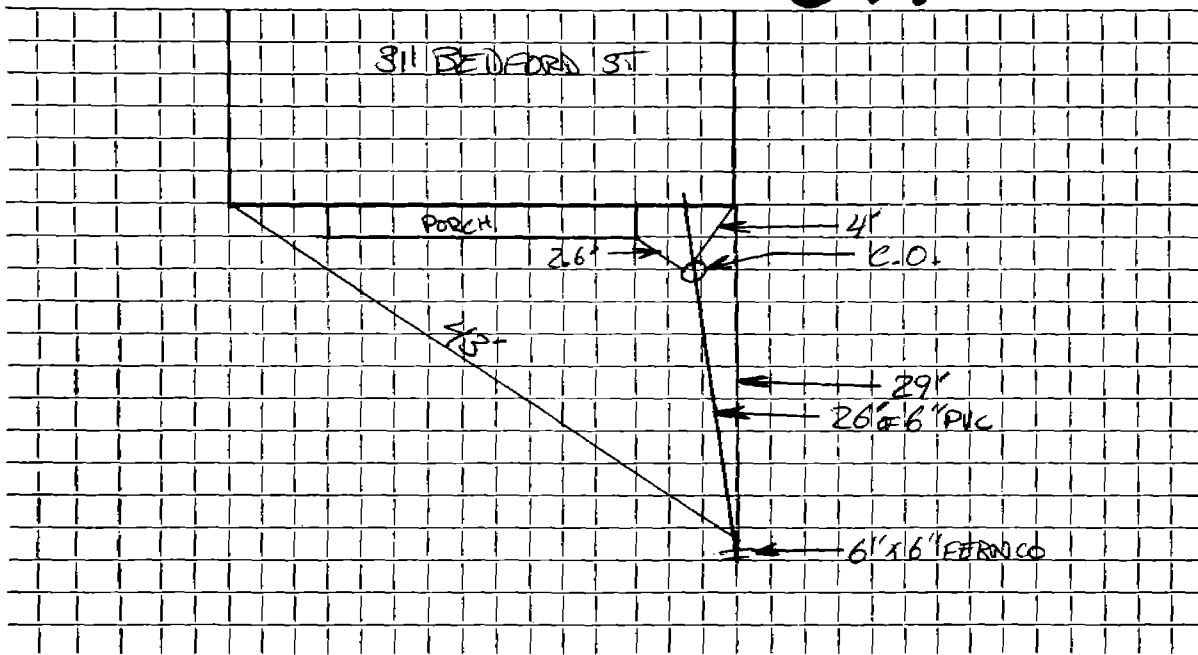

Connection made in Street. Work completed

Remarks:

.....

.....