Address 315 Bedford STreeT


Location			
	 	 	====

Kind of	Pipe		Size		Size of Main	Size of Main		
Repair—	Renewal—New Service		Location					
Date	Material	Amount	Total	Date		Amount		
4-8-52								
62	6" Sewer Pipe							
	<u>'</u>			<u> </u>				
		<u> </u>						
	 	 	 					
	 					 		
	 							
	<u> </u>					 		
+						t		
				#				
				·				
		Ţ -	i	11				

A 7	ΓΕ				
 -					

TOWN OF LEXINGTON — BOARD OF PUBLIC WORKS SEWER DIVISION

Sketch of Service Here

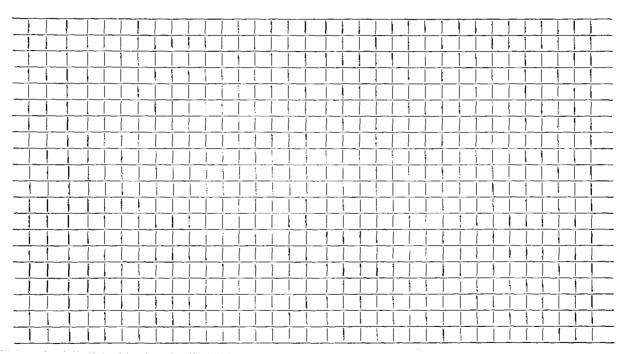

Connection made in	Street.	Work completed	
Remarks:			• • • • • • • • • • • • • • • • • • • •