

Name Murray Dearborn

Service No. 98

Address 328 Bedford Street

Lexington

Location

Kind of Pipe

Size

Size of Main

Repair—Renewal—New Service

Committed 12-1-52

Location

Date	Material	Amount	Total	Date	Amount
11/4/52	Labor	63 35		7-9-52	Deposited 200 00
11/5/52	Labor	21 93		12-8-52	Re-funded (8 27)
	10% Overhead	8 53	93 81		191 73
	90' -6" sewer pipe @.342		30 78		
	1 - 6" 1/8 bend @1.24		1 24		
	joint compound		5 40		
	6 hrs. Littlefield shovel @7.00		42 00		
	2 hrs. trucking @.75		1 50		
	patching 17 X 3		17 00		
			191 73		
	Labor				

HP-6411

TOWN OF LEXINGTON—DEPT. OF PUBLIC WORKS

SEWER DIVISION

DATE

NO.


The undersigned applies for the construction of a particular sewer connecting No.
Street and hereby agrees to comply with the Rules and Regulations governing the construction and use of Particular
Sewers, as now or at any future time established by the Board of Selectmen.

Am't of estimate \$.....

Am't Paid \$.....

..... Owner

Sketch of Service Here

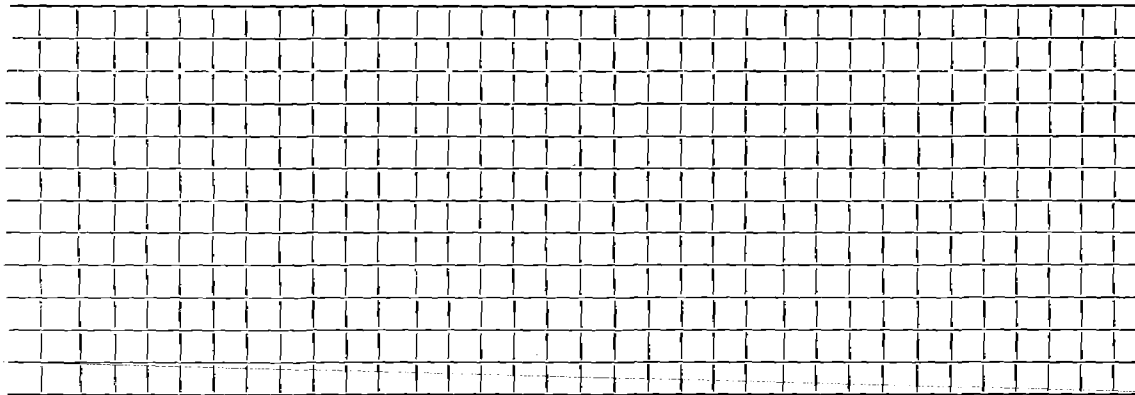

Connection made in Street.

Work completed 19..

Remarks: