

Name Howard Butler

Service No. 147

Address 329-331 Bedford St.

(1952)

Lexington

Location

Kind of Pipe

Size

Size of Main

~~Replacement~~ New Service Com. 3/30/53

Location

Date	Material	Amount	Total	Date	Amount
2/24/53	Labor	74 79			
	10% Overhead	7 48	82 27	9-18-52	Deposited 125 00
	32' - 6" sewer pipe @.342		10 94	3-30-53	Refunded (8 49
	1 - 6" elbow		1 88		116 51
	joint compound		1 92		
	2 hrs. trucking		1 50		
	patching 18 x 3		18 00		
			116 51		
	Labor				

TOWN OF LEXINGTON—DEPT. OF PUBLIC WORKS
SEWER DIVISION

DATE.....

NO.


The undersigned applies for the construction of a particular sewer connecting No.....
Street and hereby agrees to comply with the Rules and Regulations governing the construction and use of Particular
Sewers, as now or at any future time established by the Board of Selectmen.

Am't of estimate \$.....

Am't Paid \$.....

..... Owner

Sketch of Service Here

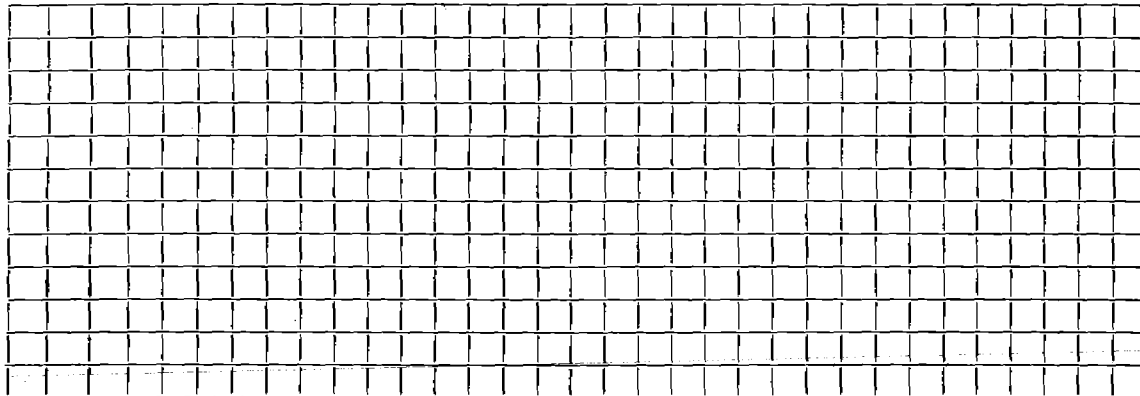

Connection made in..... Street.

Work completed.....19..

Remarks: