

Name

Service No.

Address

333 Bedford St.

Location

Kind of Pipe

Size

Size of Main

Repair—Renewal—New Service

Location

Date

Material

Amount

Total

Date

Amount

6-1-59

24' 6" Transite


1 6" Clay Elbow

DATE _____

TOWN OF LEXINGTON BOARD OF PUBLIC WORKS

SEWER DIVISION

Sketch of Service Here

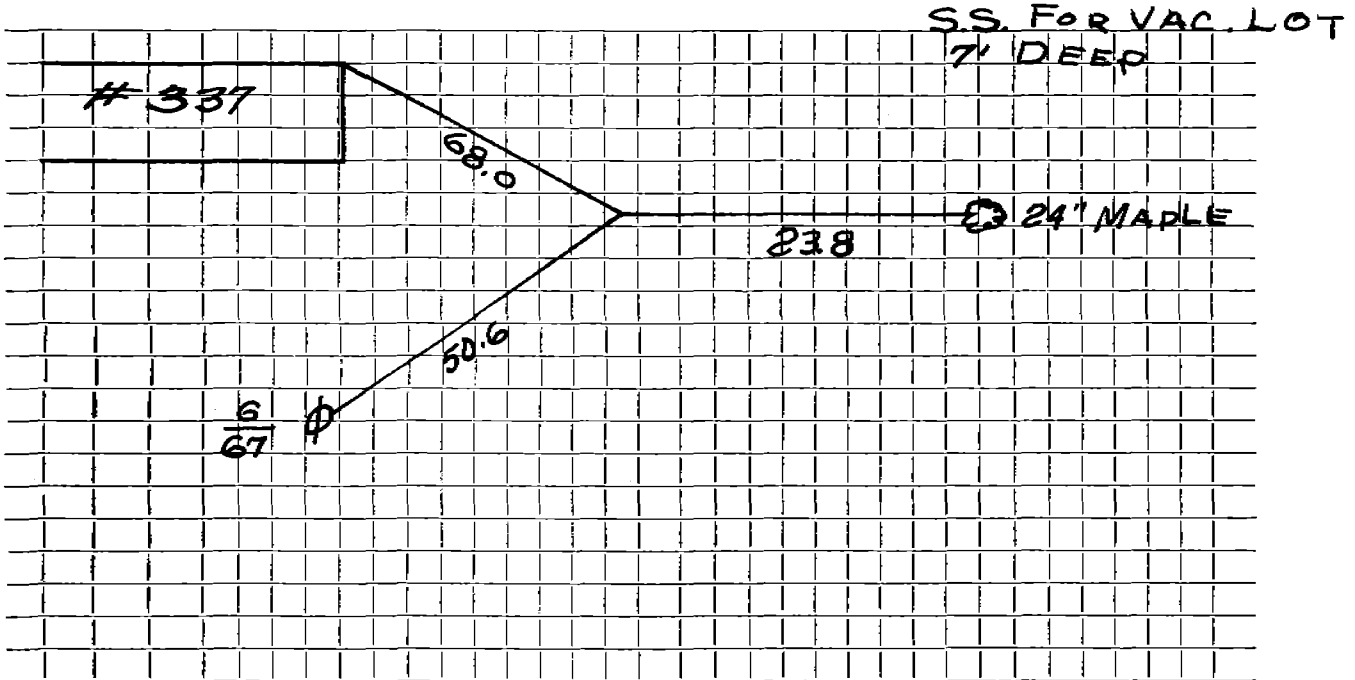

Connection made in Street. Work completed

Remarks:
.....
.....