

Name Outhet Realty Trust

Service No. 126

Address 341 Bedford Street

Location

Kind of Pipe

Size

Size of Main

Repair ~~Renewal~~ - New Service

Location Comm 11-24-58

Date	Material	Amount	Total	Date		Amount
7/28/58	Labor	93 50		7-15-58	Deposit	150 00
	10% overhead	9 35		7-27-58	Paid by W.H.C. # 270	24 44
			102 85		Paid by W.H.C. # 270	16 81
	70' 6" transite pipe @.70		49 00	3-16-59	Paid by W.H.C. # 270	11 44
	1 6" Clay elbow		1 88	3-27-59	Paid	25 48
	3 hrs. town shovel @6.50		19 50			203 73
	2 hrs. trucking @.75		1 50			
	29 x 3 patch		29 00			
			203 73			
	Labor					

TOWN OF LEXINGTON—DEPT. OF PUBLIC WORKS

SEWER DIVISION

DATE.....

NO.


The undersigned applies for the construction of a particular sewer connecting No.....
 Street and hereby agrees to comply with the Rules and Regulations governing the construction and use of Particular
 Sewers, as now or at any future time established by the Board of Selectmen.

Am't of estimate \$.....

Am't Paid \$.....

..... Owner

Sketch of Service Here

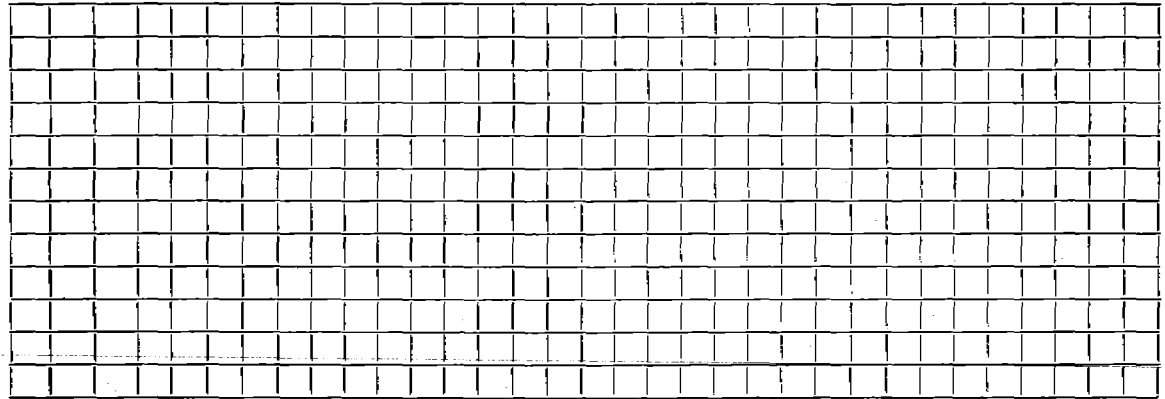

Connection made in..... Street.

Work completed.....19..

Remarks: