

Name Gulf Oil Station  
 Address 35 BEDFORD ST +  
 39 Bedford Street

Service No.

Location

Kind of Pipe

Size

Size of Main

Repair—Renewal—New Service

Taverna Bros. #1307


Location

Date		Material	Amount	Total	Date		Amount
5-23-69	146	4" Cast Iron Pipe					
					6-17-83		
						1 Fernco Adaptor	
						1 2'X6' ACP Nipple	
						1 6" X 3' Transite Nipple	
						1 6" X 1' Transite Nipple	
					6-15-83	Pipe Broken Approx 14' out from M.H.	

DATE \_\_\_\_\_

TOWN OF LEXINGTON — BOARD OF PUBLIC WORKS  
SEWER DIVISION

Sketch of Service Here **35 & 39**

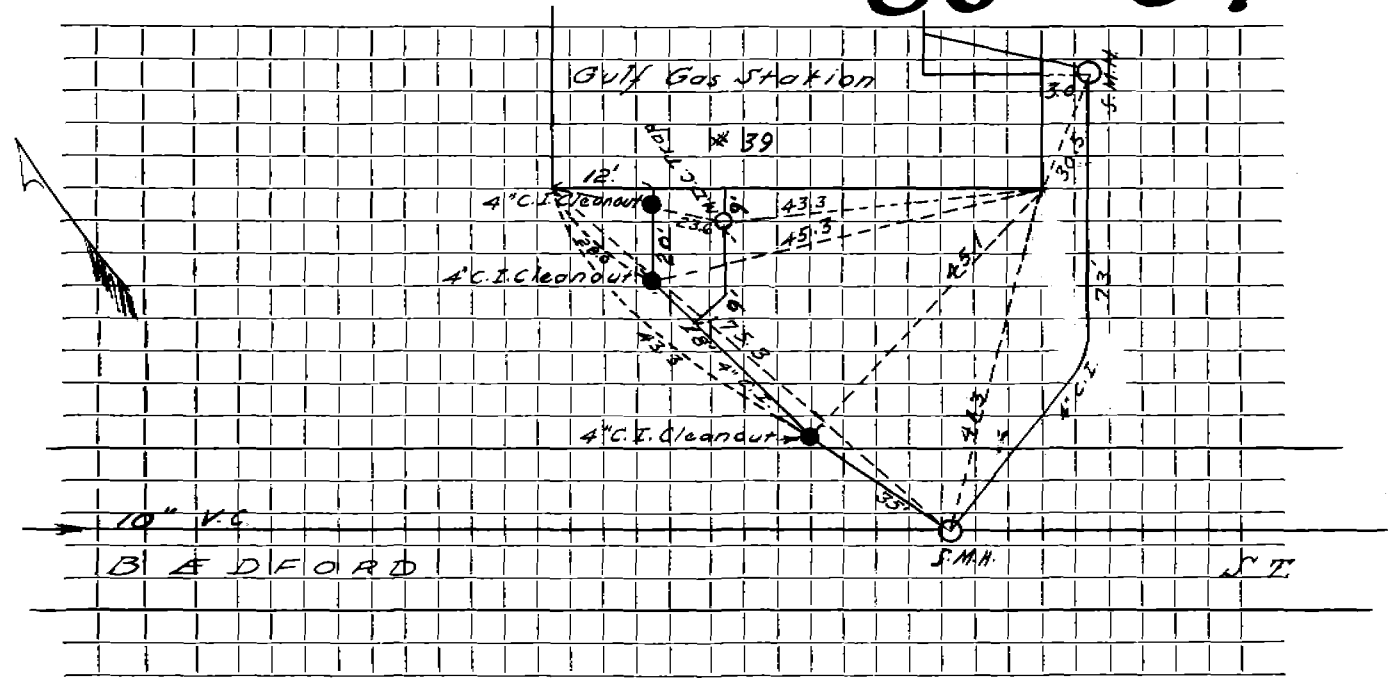

Connection made in ..... Street. Work completed .....

Remarks: .....  
.....  
.....

*lee*