

Name Rowe Chevrolet

Service No. 243

Address ~~37-39-11~~ Bedford Street

Changed to #37 Bedford Street - per Eng. Dept. 12/11/68 Location

Kind of Pipe

Size

Size of Main

~~XXXXXXXXXX~~ New Service DeFlice Bros. Permit #122 W.O. #1318

Location

MAR 14 1968


Date	Material	Amount	Total	Date	Amount
12-8-65	Labor	32 40			
	O.H. 10%	3 24	35 64	11-22-65	Deposit 150 00
				3-14-66	* Refund 78 80
25'	6" Transite pipe @ .82		20 50		71 30
1/2	Bag Cement @ 1.50		75		
2	Doz Brick @ 4.20 per 100		1 01		
1	Hr. Shovel		6 50		
1/2	Hr. Loader @ 4.00		2 00		
1/2	Hr. Town Truck @ 3.00		1 50		
3	Ton Gravel @ 1.10		3 30		
			71 20		
12-14-65	58' 6" Transite pipe				
					* Apply 54.20 to permit #136

DATE _____

**TOWN OF LEXINGTON — BOARD OF PUBLIC WORKS
SEWER DIVISION**

Sketch of Service Here

37

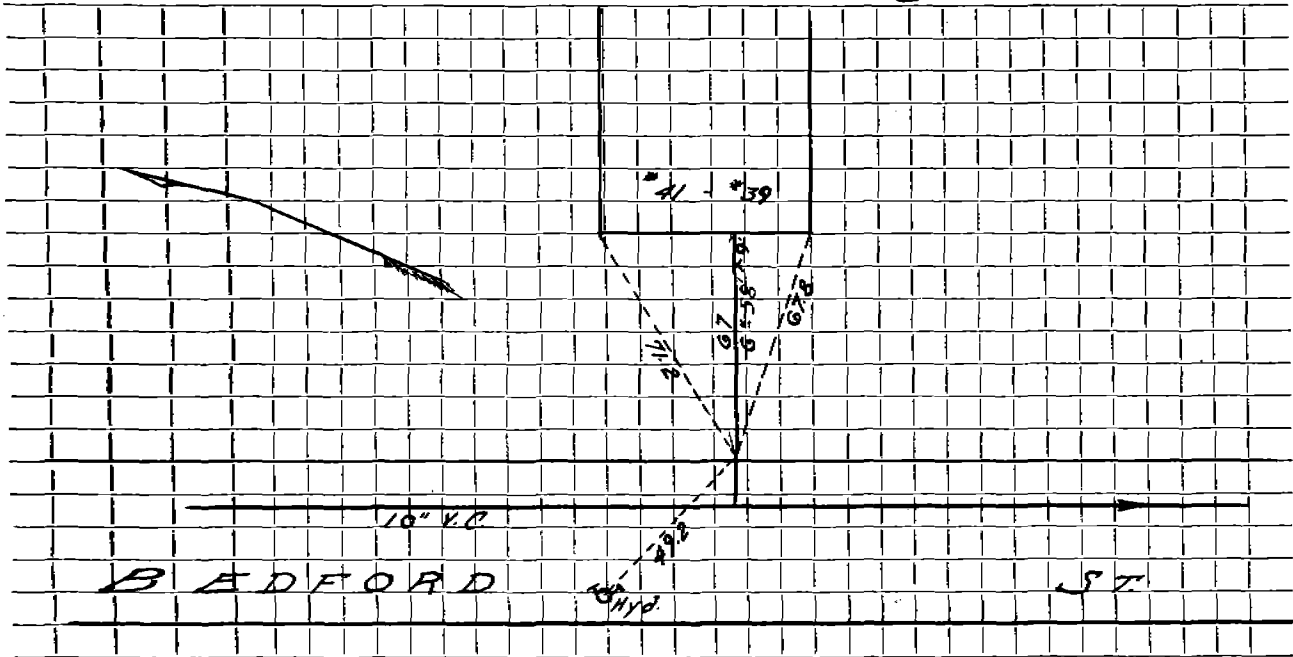

Connection made in Street. Work completed

Remarks:

.....

.....