

Name Clara E. Bunzel

Service No. 52

Address 397 Bedford St.

Lexington

Location

Kind of Pipe

Size

Size of Main

~~Repair - Renewal~~ New Service COM. 6-8-53

Location

Date	Material	Amount	Total	Date	Amount
5/7/53	Labor	54 17		3-31-53	Deposited 175 -
5/8/53	"	12 50	66 67	6-8-53	Refunded (34 79
	10% overhead		6 67		140 21
	46' - 6" sewer pipe @ .342		15 73		
	1 - 6" elbow		1 88		
	joint compound		2 76		
	4 hrs. Littlefield shovel @7.50		30 00		
	2 hrs. trucking @ .75		1 50		
	patching 15 x 3		15 00		
			<u>140 21</u>		
	<b>Labor</b>				

**TOWN OF LEXINGTON—DEPT. OF PUBLIC WORKS**  
**SEWER DIVISION**

DATE.....

NO.....

The undersigned applies for the construction of a particular sewer connecting No.....  
Street and hereby agrees to comply with the Rules and Regulations governing the construction and use of Particular  
Sewers, as now or at any future time established by the Board of Selectmen.


Am't of estimate \$.....

Am't Paid \$.....

..... Owner

---

**Sketch of Service Here**

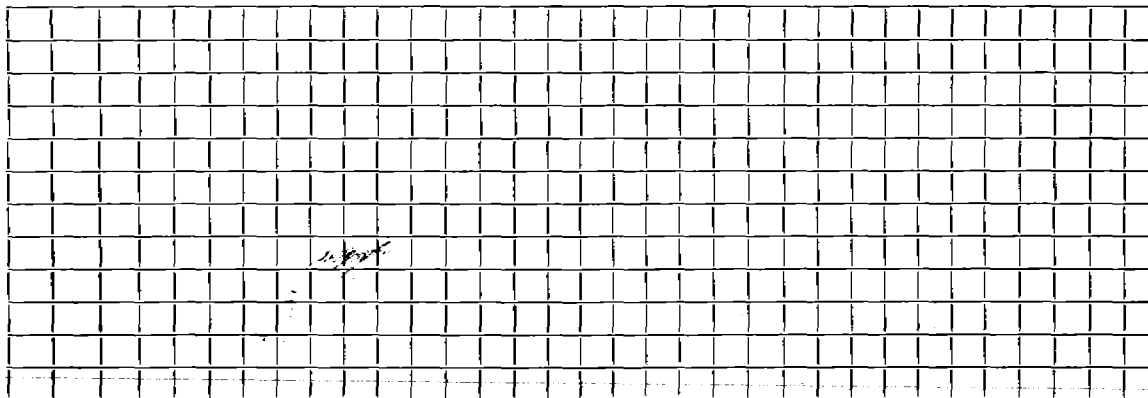

Connection made in ..... Street.

Work completed.....19..

Remarks: