

SEWER BEYOND CENTER OF STREET

Name

Service No.

Address 404 Bedford St.

SERVICE INTO CURB

Location

Kind of Pipe

Size

Size of Main

~~Repair~~ ~~Renewal~~ — New Service

Location

Date	Material	Amount	Total	Date	Amount
9/23/53	Labor	50 20			
	10% overhead	5 02	55 22		
	22'-6" Sewer Pipe @.3036		6 68		NON CHARGE
	Joint Compound		1 32	8/23/53	Labor
	2 Hr. Town Shovel @5.00		10 00		33 00
	1 Hr. Trucking		75		12'-6" Sewer Pipe @.3036
12-16-53	New Service		73 97		3 64
	136' 6" Sewer Pipe				Joint Compound
					72
					1 Hr. Town Shovel @5.00
					5 00
					1 Hr. Trucking
					75
					<u>43 11</u>
	Labor				

TOWN OF LEXINGTON—DEPT. OF PUBLIC WORKS
SEWER DIVISION

DATE

NO.

The undersigned applies for the construction of a particular sewer connecting No.
 Street and hereby agrees to comply with the Rules and Regulations governing the construction and use of Particular
 Sewers, as now or at any future time established by the Board of Selectmen.


Am't of estimate \$

Am't Paid \$

..... Owner

Sketch of Service Here

404

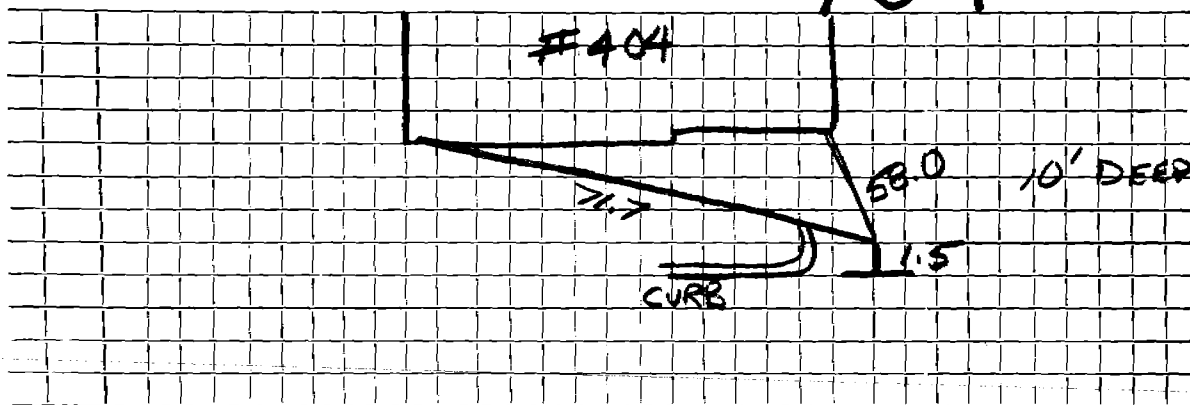

Connection made in Street.

Work completed 19..

Remarks: