

Name Mrs. Bernard Porter

Service No. 105

Address 411 Bedford Street

Location

Kind of Pipe Size Size of Main

~~Repair~~ ~~Renewal~~ — New Service COM. 7-13-53 Location

Date	Material	Amount	Total	Date	Amount
6/23/53	Labor	73 60		6-2-53	125 -
	10% overhead	7 36	80 96	7-13-53	(6 36)
	48' - 6" sewer pipe @ .342		16 42		118 64
	1 - 6" elbow		1 88		
	joint compound		2 88		
	3 hrs.town shovel @ 5.00		15 00		
	2 hrs.trucking @ .75		1 50		
			118 64		
	<b>Labor</b>				

TOWN OF LEXINGTON—DEPT. OF PUBLIC WORKS  
SEWER DIVISION

DATE.....

NO. ....

The undersigned applies for the construction of a particular sewer connecting No.....  
Street and hereby agrees to comply with the Rules and Regulations governing the construction and use of Particular  
Sewers, as now or at any future time established by the Board of Selectmen.


Am't of estimate \$.....

Am't Paid \$.....

..... Owner

Sketch of Service Here

411

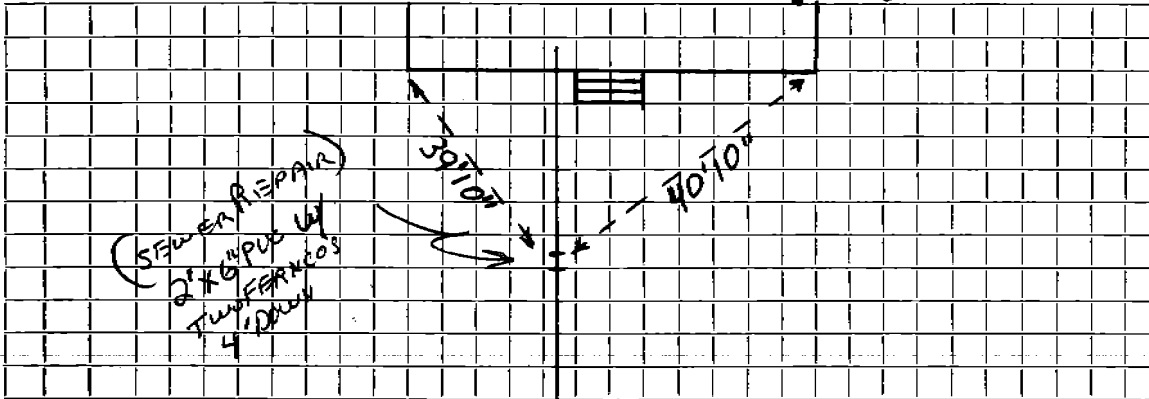

Connection made in BEAUFORD ST Street.

Work completed.....19..

Remarks: