


DATE 3/2018

TOWN OF LEXINGTON — BOARD OF PUBLIC WORKS
SEWER DIVISION

Sketch of Service Here

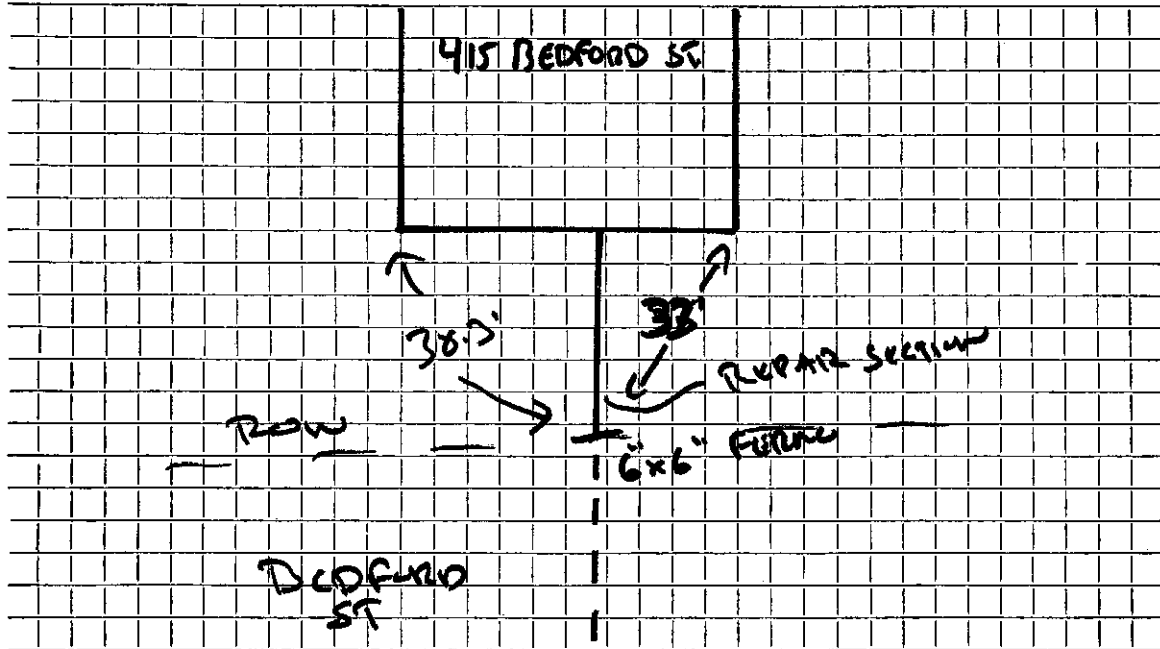

Connection made in Bedford Street. Work completed Ernie's Excavating

Remarks:

.....

.....