

Name Mr. Spinosa

Service No. 2

Address 419 Bedford St.

Location

Kind of Pipe

Size

Size of Main

~~Repair~~ ~~Renewal~~ ~~New Service~~

WO. #4005

Location


Date	Material	Amount	Total	Date		Amount
1/26/76				1-26-76	Deposit	250.00
4	5' X 6" transite nipple @ 1.56		31.20	8-16-76	Refund	175.00
2	11' X 4° EIs @ 3.84		7.68			25.00
1	30° E1		4.75	9-22-53		
1	45° E1		4.75		20' 6" Sewer Pipe	
2	12" X 6" nipple @ 2.44		4.88			
1	6" X 6" nipple		1.71			
1	6" cap		3.75			
1	11½° sweep		6.76			
1	6" X 6" wye		9.52			
			<u>75.00</u>			

DATE _____

TOWN OF LEXINGTON — BOARD OF PUBLIC WORKS
SEWER DIVISION

Sketch of Service Here

419

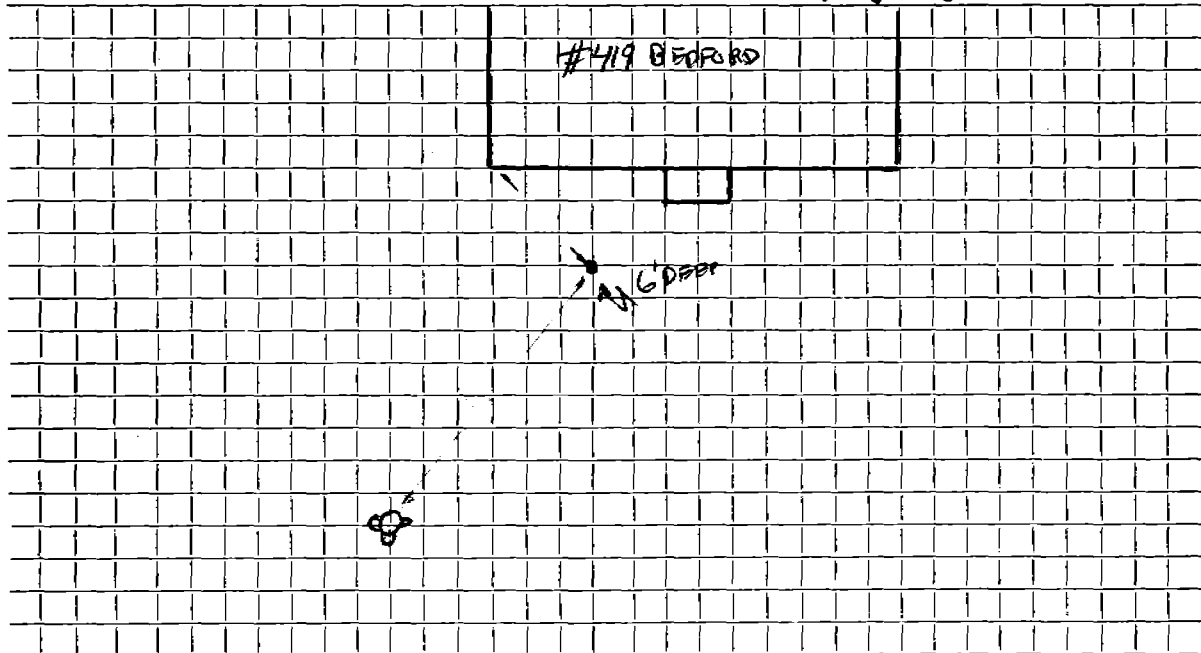

Connection made in Street. Work completed

Remarks: *Original Service 9-22-53*

.....
.....