

Name Raymond Turcott

Service No.

Address 424 Bedford Street

Location

Kind of Pipe

Size

Size of Main

~~Repair~~ ~~Renewal~~ ~~New Service~~ SERVICE IN TO CURB
TO BE CHARGED WHEN CONNECTED:

Location

Date	Material	Amount	Total	Date		Amount
9/17/53	Labor	27 70				
	10% overhead	2 77	30 47		<u>NON CHARGE</u>	
	18' - 6" sewer pipe @.3036		5 46	9/17/53	Labor	27 70
	1 - 6" elbow		1 88		16' - 6" sewer pipe @ .3036	4 86
	joint compound		1 08		joint compound	96
	2 hrs. town shovel @ 5.00		10 00		2 hrs. town shovel @ 5.00	10 00
	1 hr. trucking		75		1 hr. trucking	75
	patching 12 x 3		12 00		patching 15 x 3	15 00
			61 64			59 27
	Labor					

TOWN OF LEXINGTON—DEPT. OF PUBLIC WORKS
SEWER DIVISION

DATE

NO.


The undersigned applies for the construction of a particular sewer connecting No.
Street and hereby agrees to comply with the Rules and Regulations governing the construction and use of Particular
Sewers, as now or at any future time established by the Board of Selectmen.

Am't of estimate \$.....

Am't Paid \$.....

..... Owner

Sketch of Service Here **424**

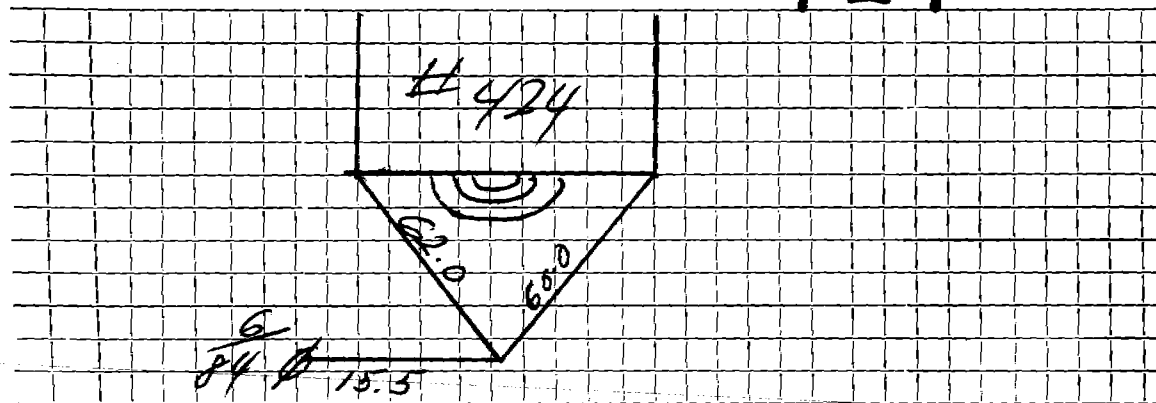

Connection made in Street.

Work completed 19..

Remarks: