

Name: Chalet Susse International

Service No. 5

Address 440 Bedford Street

Location

Kind of Pipe

Size

Size of Main

Repair—Renewal—New Service

W.O. # 7485 McGovern Const. #1623

Location

NOV 23 1970


Date	Material	Amount	Total	Date	Amount
6/22/70	Labor	244 08		8-1-70	800 00
	Police	100 00		9-3-71	945 85
6/23/	Labor	140 62			1745 85
7/23/	Labor	155 42			
7/24/	Labor	143 96	784 08		
	10% O.H.		78 41		
56!	8" Transite pipe 1.20		67 20		
9	Ton cold patch 6.00		54 00		
13	" hot top 6.00		78 00		
3	Loads gravel 14.00		42 00		
8	Ton Stone 1.65		13 20		
10	Yds. concrete 20.35		203 50		
10	Ton ready mix 74.15		183 50		
2	Rolls reinforced wire 27.23		54 46		
14	Hrs. trucking 3.00		42 00		
13	shovel 8.50		84 50		
3	" compressor 5.00		15 00		
4	loader 5.00		20 00		
2	" roller 2.00		4 00		
	trailer		2 00		
			1602 35		
			1795 85		
7/17/70	258' 8" Transite pipe				
	15' 4" Cast Iron Pipe			10-3-74	Sewer Blockage
				6-9-84	S.B. PAPERS

DATE _____

TOWN OF LEXINGTON — BOARD OF PUBLIC WORKS
SEWER DIVISION

Sketch of Service Here

440

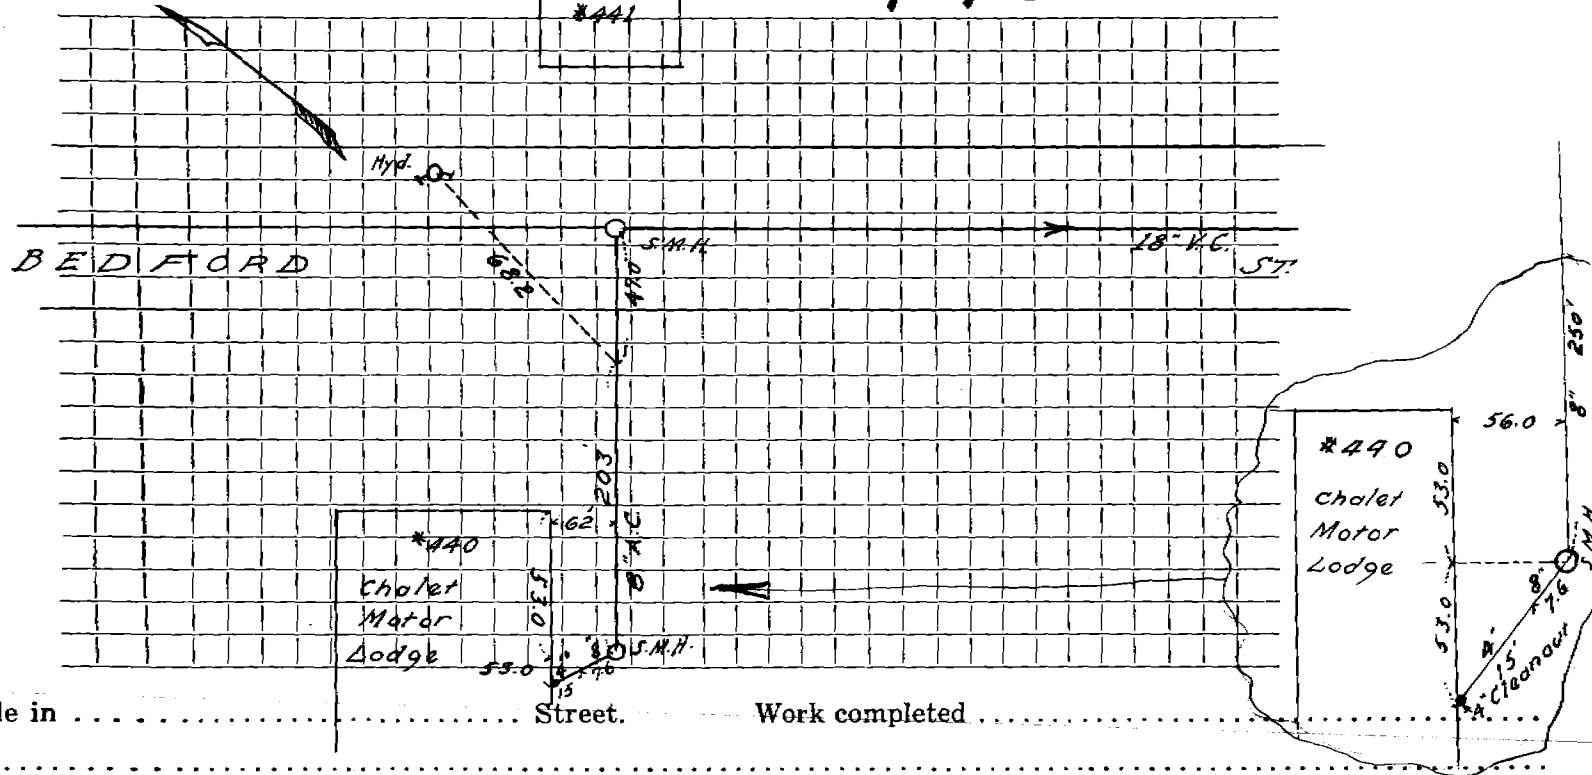

Connection made in Street. Work completed

Remarks:

.....

Name Denny's RESTAURANT

Service No.

Address 440 BEDFORD ST

Location

Kind of Pipe

Size

Size of Main

Repair—Renewal—New Service

Location

Date

Material

Amount

Total

Date


Amount

DATE _____

TOWN OF LEXINGTON — BOARD OF PUBLIC WORKS

SEWER DIVISION

Sketch of Service Here **440**

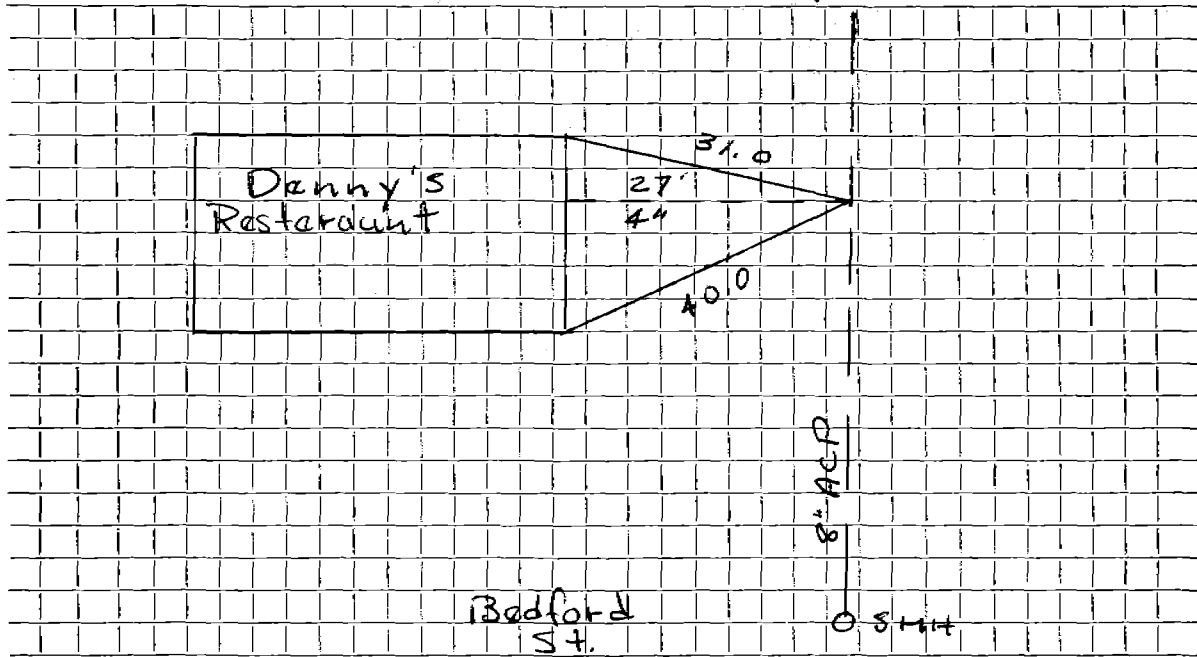

Connection made in Street. Work completed

Remarks:
.....
.....