

Name Ralph J. Frissore

Service No. 113

Address 443 Bedford St.

Location

Kind of Pipe

Size

Size of Main

~~Repair~~ ~~Renewal~~ — New Service

com. 8-15-55

Location

Date	Material	Amount	Total	Date	Amount
6/21/55	Labor	70 04		6-7-55	Deposited 200 00
	10% overhead	7 00	77 04	8-15-55	Refunded 78 74
	44' - 6" sewer pipe @ .32		14 08		121 26
	joint compound		2 64		
	4 hrs. town shovel @ 5.00		20 00		
	2 hrs. Allis chalmers @ 3.00		6 00		
	2 hrs. trucking @ .75		1 50		
			121 26		
	Labor				

**TOWN OF LEXINGTON—DEPT. OF PUBLIC WORKS
SEWER DIVISION**

DATE

NO.


The undersigned applies for the construction of a particular sewer connecting No.
Street and hereby agrees to comply with the Rules and Regulations governing the construction and use of Particular
Sewers, as now or at any future time established by the Board of Selectmen.

Am't of estimate \$.

Am't Paid \$.

..... Owner

Sketch of Service Here

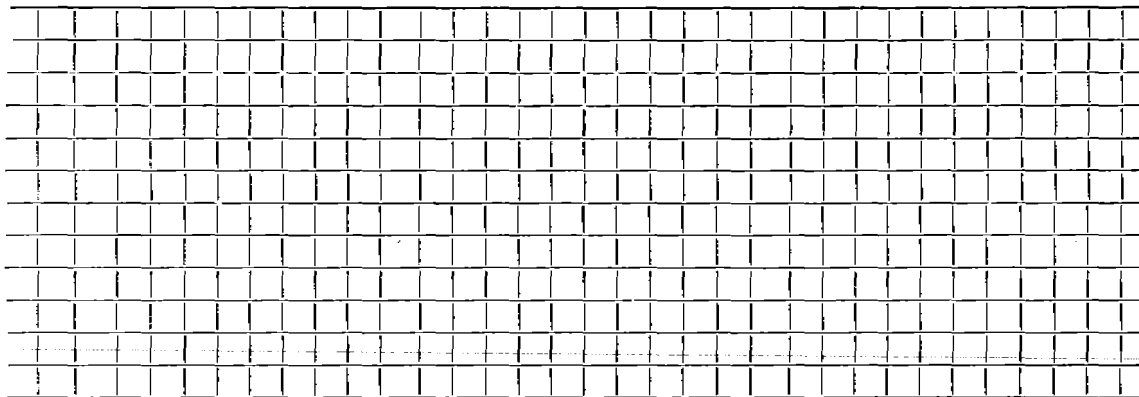

Connection made in Street.

Work completed 19..

Remarks:

