

Name Ralph J. Frissore

Service No. 22

Address 149 Bedford Street

Location

Kind of Pipe

Size

Size of Main

~~Repair~~ ~~Renewal~~ - New Service

COM. 5-9-55

Location

Date	Material	Amount	Total	Date	Amount
4/4/55	Labor	23 50		3-24-55	150 00
4/5/55	"	62 89	86 39	5-9-55	( 6 07
	10% overhead		8 64		143 93
	54' - 6" sewer pipe @ .32		17 28		
	1 - 6" elbow		1 88		
	joint compound		3 24		
	3 hrs. town shovel @ 5.00		15 00		
	2 hrs. trucking @ .75		1 50		
	patching 10 x 3		10 00		
			143 93		
	<b>Labor</b>				

*Deposited*  
*\*Refunded*  
 \* Refund made payable  
 to town to apply on  
 to sewer conn. #15

TOWN OF LEXINGTON—DEPT. OF PUBLIC WORKS  
**SEWER DIVISION**

DATE.....

NO. ....

The undersigned applies for the construction of a particular sewer connecting No.....  
Street and hereby agrees to comply with the Rules and Regulations governing the construction and use of Particular  
Sewers, as now or at any future time established by the Board of Selectmen.


Am't of estimate \$.....

Am't Paid \$.....

..... Owner

---

**Sketch of Service Here**

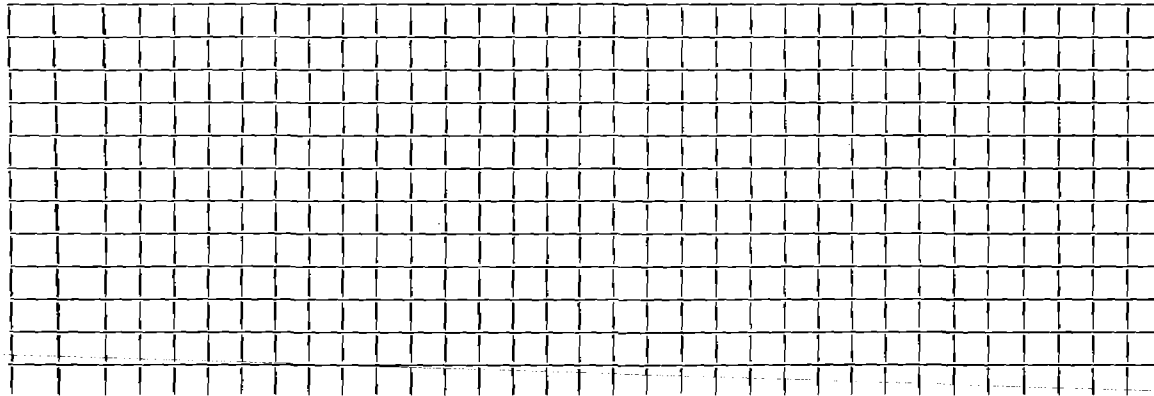

Connection made in ..... Street.

Work completed.....19..

Remarks: