

Name New Fire Station

Service No. 40 1053

Address ~~49~~<sup>45</sup> Bedford Street

LEXINGTON, MASS.

Location ~~49~~<sup>45</sup> Bedford Street

Kind of Pipe

Size

Size of Main

~~Repair - Renewal~~ - New Service

Location

Date	Material	Amount	Total	Date	Amount
Nov. 6, '46	Labor	45 00		Mar. 21 '46	128 50
7	"	20 70			
8	"	<u>1 43</u>	67 13		
	10% Overhead		6 71		
	44' - 6" Sewer Pipe @.24		10 56		
	14' - 6" Water Pipe @1.12		15 68		
	2 - 6" Elbows @ .70		1 40		
	Joint Compound		2 64		
	Patching 15 x 3		15 00		
	Compressor 4½ hrs. @1.75		7 88		
	Trucking 2 hrs. @.75		<u>1 50</u>		
	Labor		128 50	10-13-75	2/3/69 / Sewer/Block
				16-13-75	

TOWN OF LEXINGTON—DEPT. OF PUBLIC WORKS  
**SEWER DIVISION**

DATE .....

NO. ....

The undersigned applies for the construction of a particular sewer connecting No. ....  
Street and hereby agrees to comply with the Rules and Regulations governing the construction and use of Particular  
Sewers, as now or at any future time established by the Board of Selectmen.


Am't of estimate \$. ....

Am't Paid \$. ....

..... Owner

Sketch of Service Here

4-5

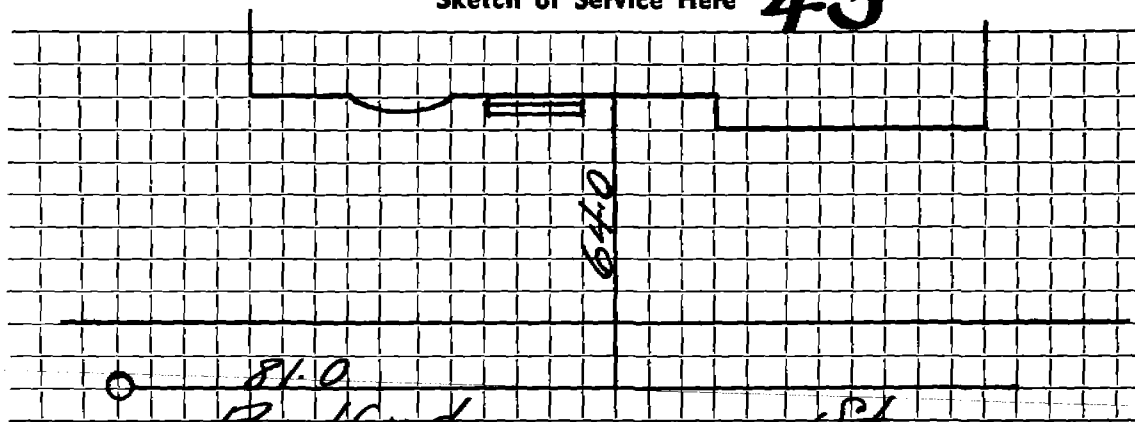

Connection made in ..... Street.

Work completed ..... 19..

Remarks: