


DATE JULY 13, 2010

TOWN OF LEXINGTON — BOARD OF PUBLIC WORKS
SEWER DIVISION

Sketch of Service Here

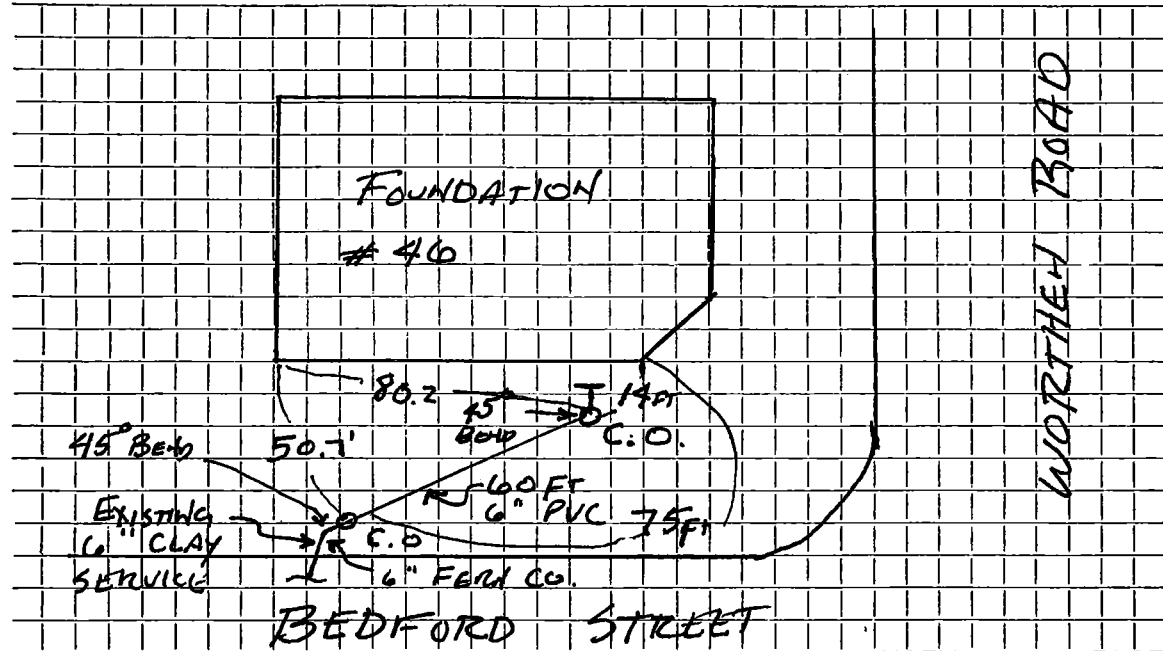

Connection made in Street. Work completed

Remarks: TWO CLEAN-OUTS @ 45° BENDS CLEAN-OUTS @ 45° BENDS
INSTALLED TO REDIRECT SEWER SERVICE TO AVOID
ON-SITE DRAINAGE SYSTEM.