

Mrs. E. C. Phelps

Service No. 17 57

Address ~~503 Perry~~ Road

Location <sup>47+49</sup> ~~45~~ Bedford St., (Camelia Place)

Kind of Pipe

Size

Size of Main

Repair—Renewal—New Service

Location

| Date<br>1938       | Material                | Amount | Total | Date                   | Amount       |
|--------------------|-------------------------|--------|-------|------------------------|--------------|
| 6/10/38            | 10½ hrs. @ 50¢          | 5 25   |       | June 1, 1938 Deposited | 80 00        |
| <i>Conv 7-5-38</i> | 26 " @ 55¢              | 14 30  |       | July 17, 1938 Refunded | 26 56        |
|                    | 8½ " 60¢                | 5 10   |       |                        | <u>53 44</u> |
|                    | 8½ " 70¢                | 5 95   | 30 60 |                        |              |
|                    | 10 % Overhead           |        | 3 06  |                        |              |
|                    | 58' 6" Sewer Pipe @ 20¢ |        | 11 60 |                        |              |
|                    | 1 6 x 6 Y               |        | 1 00  |                        |              |
|                    | 2 bags cements          |        | 1 20  |                        |              |
|                    | Gravel                  |        | 1 00  |                        |              |
|                    | Jointing compound       |        | 3 48  |                        |              |
|                    | Trucking - 2 hrs. @ 75¢ |        | 1 50  |                        |              |
|                    |                         |        | 53 44 |                        |              |
|                    | Labor                   |        |       |                        |              |

Sewer Pipe, Inc., Lexington

TOWN OF LEXINGTON—BOARD OF PUBLIC WORKS

SEWER DIVISION

(43 Bedford St.)

DATE June 1, 1938.

NO. \_\_\_\_\_

The undersigned applies for the construction of a particular sewer connecting No. Camellia Place Street and hereby agrees to comply with the Rules and Regulations governing the construction and use of Particular Sewers, as now or at any future time established by the Board of Selectmen.


Am't. of Estimate \$ 80<sup>00</sup>

Am't. Paid \$ \_\_\_\_\_

Elizabeth C. Pleaf Owner

Sketch of Service Here

**47-49**

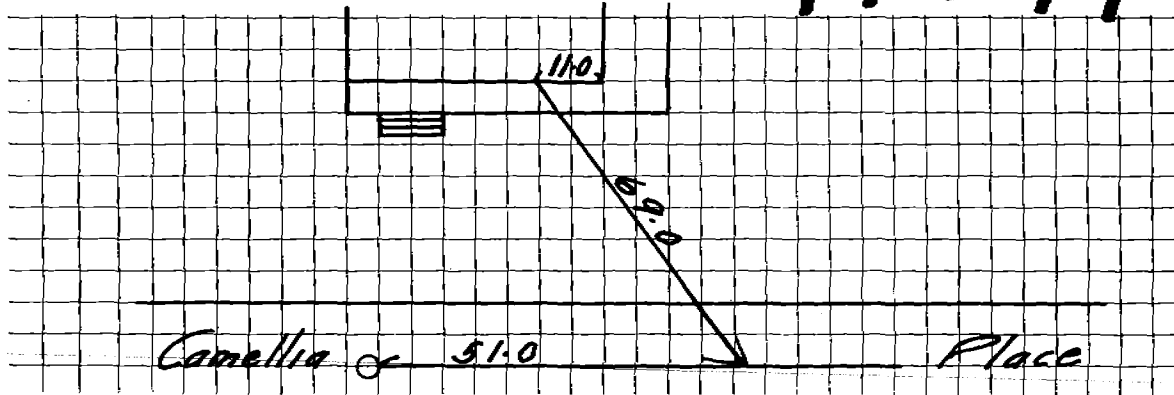

Connection made in \_\_\_\_\_ Street.

Work completed \_\_\_\_\_ 19

Remarks: