

Name

Service No.

Address

47 Bedford St. Camellia Place

Location

Kind of Pipe

Size

Size of Main

~~Repair~~—Renewal—New Service # 7948


Location

Date	Material	Amount	Total	Date		Amount
					OUTSIDE	
				Feb. 7, 1969	Labor	102 88
					12'-6" Transite	.88 10 56
					1 Adaptor	2 76
					200 Brick 4.20	per 100 8 40
					1 Frame & Cover	35 00
					2 Bags Cement 1.55	3 10
					2 Hrs. Trucking 3.00	6 00
					1 " Compressor	5 00
					2 " Shovel 6.50	13 00
					1 " Myers	4 00
						190 70

DATE \_\_\_\_\_

TOWN OF LEXINGTON — BOARD OF PUBLIC WORKS  
SEWER DIVISION

Sketch of Service Here **47**

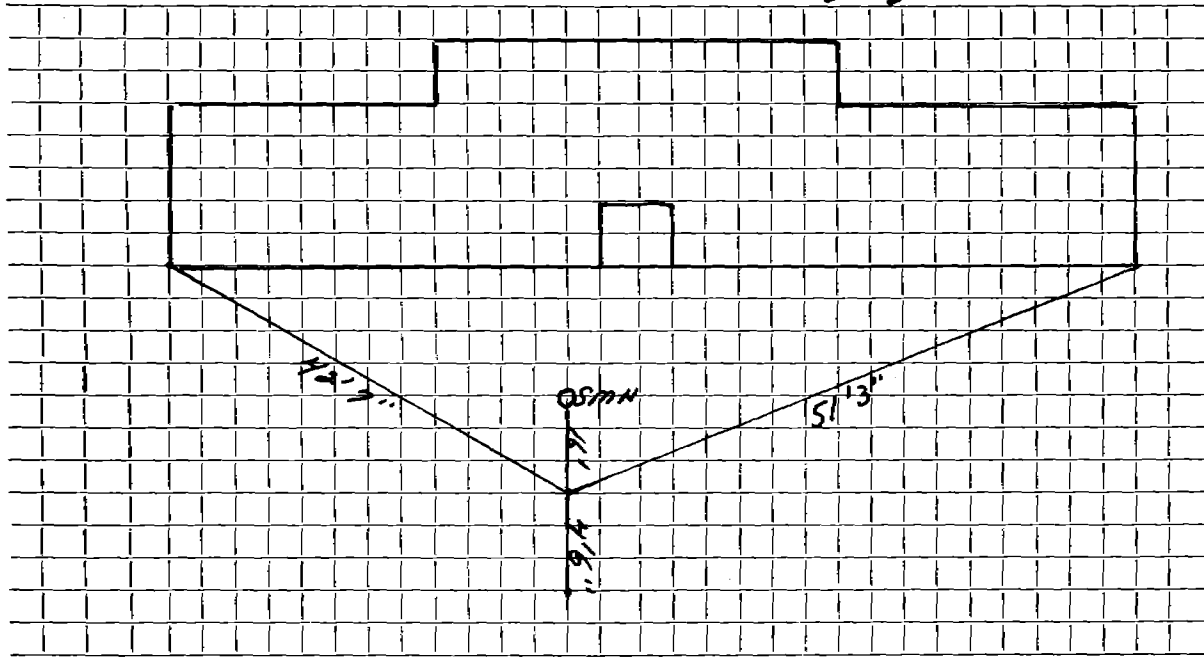

Connection made in ..... Street. Work completed .....

Remarks: .....  
.....  
.....