

Name

De Howard Smith

Service No.

Address

476 Bedford St

Location

Kind of Pipe

Size

Size of Main

Repair—Renewal—New Service

R.J. Macki RSR #1249


Location

Date	Material	Amount	Total	Date	Material	Amount
7.12.54	60' - 4" Iron pipe 44' - 6" Sewer Pipe		7.13.54	30' - 6" Sewer pipe		
6.3.99	Service added to handle new kennels on back of house		11.16.57	50' - 6" Transite		
	1- precast M.H					
	1- 220 Band					
	100' - 6" PVC pipe					
	1- 6x6x4 wye clean out					

DATE \_\_\_\_\_

TOWN OF LEXINGTON — BOARD OF PUBLIC WORKS  
SEWER DIVISION

Sketch of Service Here

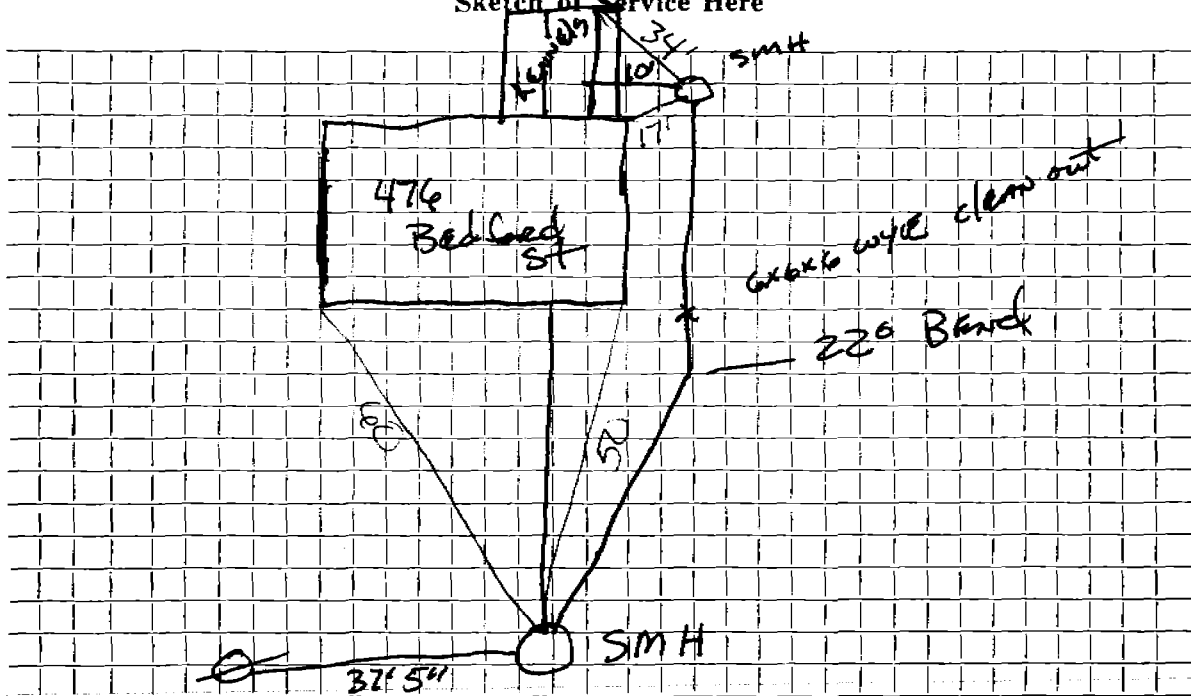

Connection made in 6.3.99 Street. Work completed .....

Remarks: SERVICE FOR KENNELS INSTALLED INTO EXISTING MH.  
IN FRONT OF HOUSE