

Name Russell Davenport

Service No. 103

Address 482 Bedford Street

Location

Comm. 10/28/57  
7/30/57

Kind of Pipe

Size

Size of Main

Repair—Renewal—New Service

Location

Date	Material	Amount	Total	Date	Amount
------	----------	--------	-------	------	--------

8/13/57 Labor 46 69

10% overhead 4 67

65' - 6" Transite Pipe @ .70 45.50

3 hrs. Town Shovel @ 6.50 19 50

2 hrs. Trucking @ .75 1 50

7-7-59 117 86

134' 6" Transite

1 6"-90° Elbow

1 6"-1 1/4" Transite Bend

8-5-57 Deposit \$ 200 00

10-28-57 Refund 82 14

\$ 117 86

7-19-54

12' 6" Sewer Pipe

Labor

TOWN OF LEXINGTON—DEPT. OF PUBLIC WORKS  
SEWER DIVISION

DATE.....

NO. ....

The undersigned applies for the construction of a particular sewer connecting No.....  
Street and hereby agrees to comply with the Rules and Regulations governing the construction and use of Particular  
Sewers, as now or at any future time established by the Board of Selectmen.


Am't of estimate \$.....

Am't Paid \$.....

..... Owner

Sketch of Service Here

482

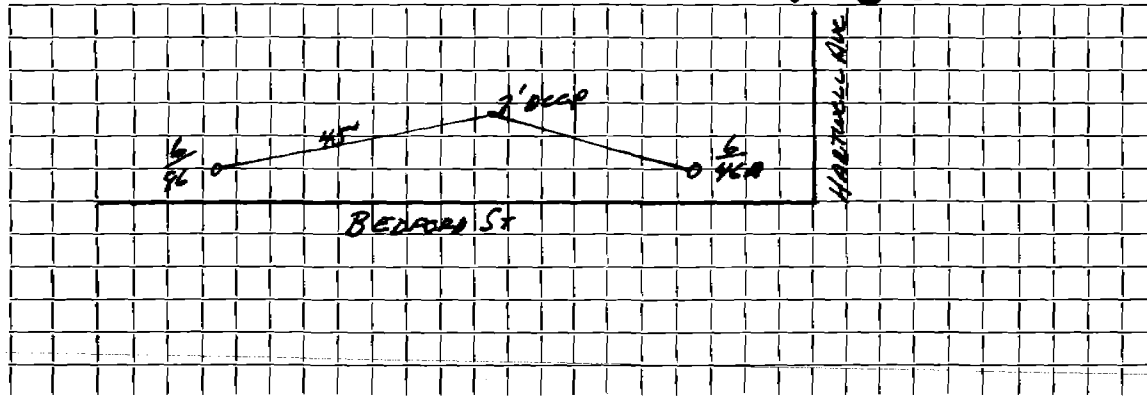

Connection made in..... Street.

Work completed.....19..

Remarks: