


DATE SEPT 17 1997

TOWN OF LEXINGTON — BOARD OF PUBLIC WORKS
SEWER DIVISION

Sketch of Service Here

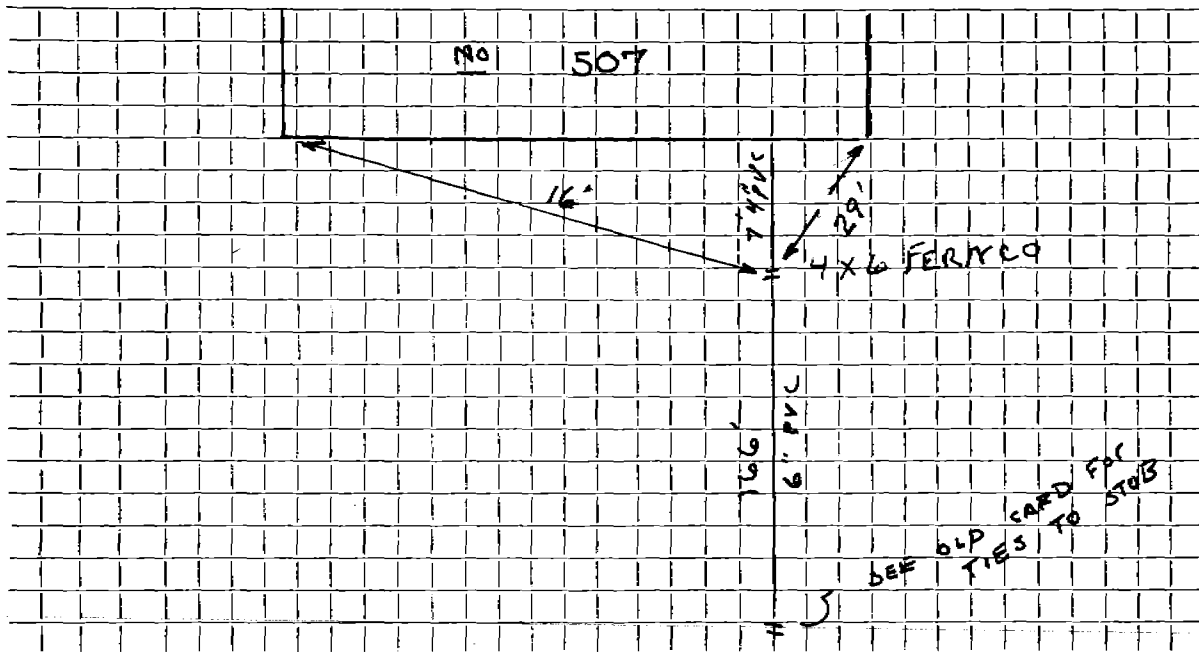

Connection made in BEDFORD Street.

Work completed by G. W. GATLEY, INC.

Remarks: BOOK 97-3