

TOWN OF LEXINGTON—DEPT. OF PUBLIC WORKS
SEWER DIVISION

DATE.....


NO.....

The undersigned applies for the construction of a particular sewer connecting No.....
 Street and hereby agrees to comply with the Rules and Regulations governing the construction and use of Particular
 Sewers, as now or at any future time established by the Board of Selectmen.

Am't of estimate \$.....

Am't Paid \$.....

..... Owner

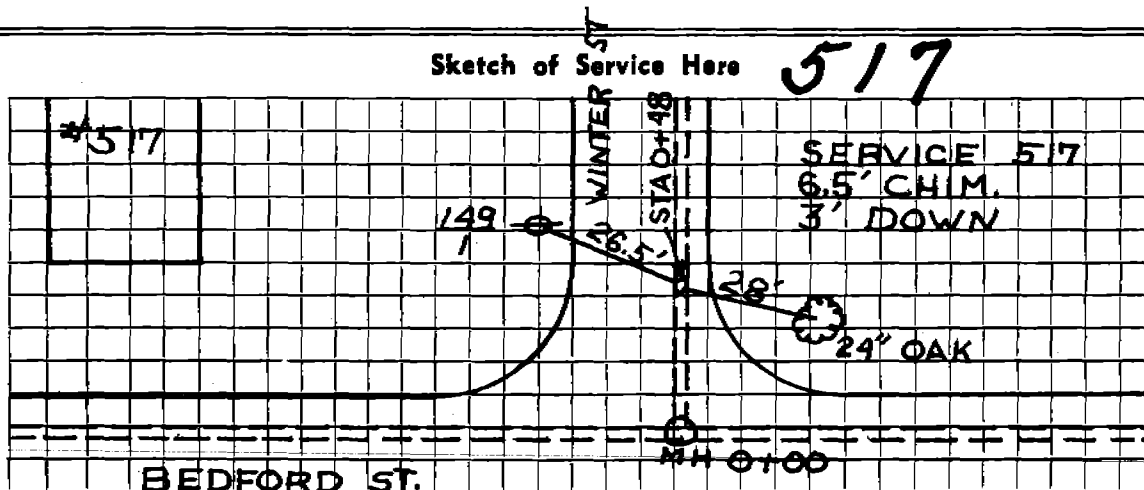

Connection made in..... Street.

Work completed.....19..

Remarks:

Name Harry A. Sandler

Service No. 55

Address 517 Bedford Street

Location

Kind of Pipe

Size

Size of Main

Repair—Renewal—New Service

W.O.# 7238

Location

Comm 7-16-62

Date	Material	Amount	Total	Date	Amount
5/23/62	Labor	89.62		5-15-62	300 00
5/25/62	"	31.14	120.76	8-6-62	40 68
		12 08	132 84		340 68
	8'6" Transite Pipe @ .78		6 24		
	1 90° Transite Elbow		5 40		
	5 Hrs. Town Shovel @ 5.50		27 50		
	3 Hrs. Trucking @ 3.00		9 00		
	1 Hr. Compressor @ 3.00		3 00		
	5 X 3 Patch		5 00		
	(Kirkland & Shaw)		151 70		
	(Install Drain - Includes)		340 68		
	(Labor & Material)				


DATE _____

TOWN OF LEXINGTON — BOARD OF PUBLIC WORKS

SEWER DIVISION

Sketch of Service Here

517

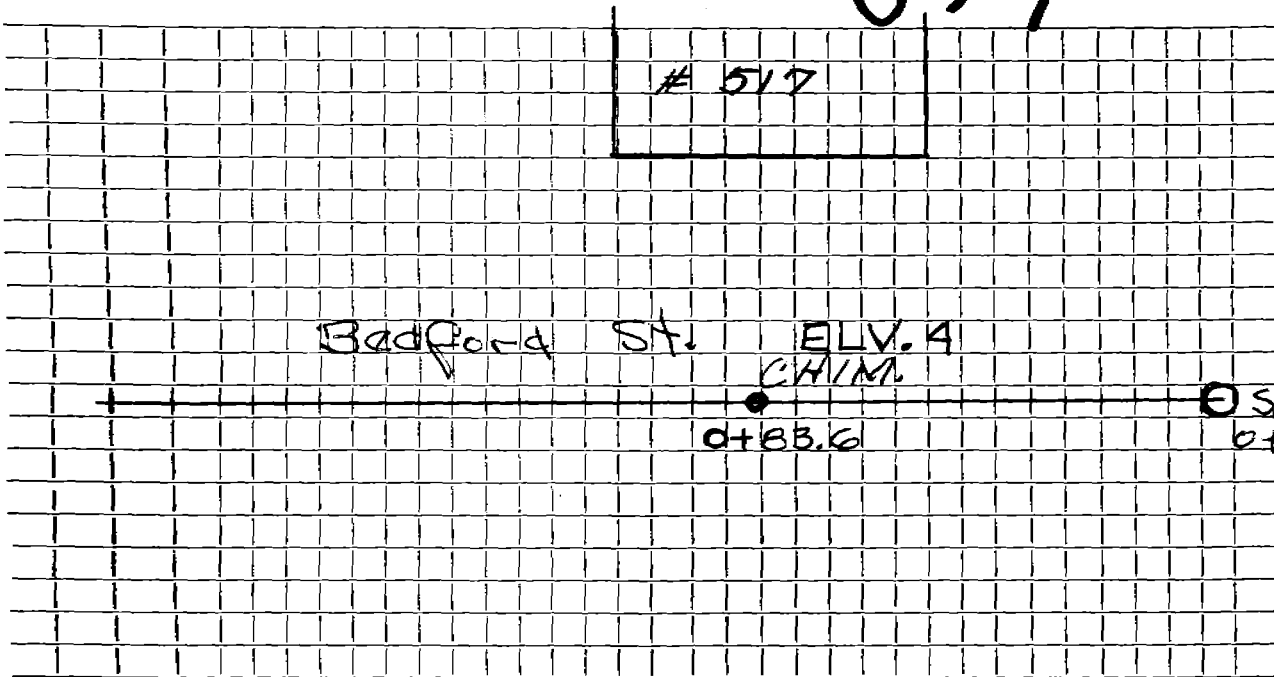

Connection made in Street. Work completed

Remarks:
.....
.....