

Name Francis Nagle

Service No. 125

Address 521 Bedford Street

Location

Kind of Pipe

Size

Size of Main

Repair—Renewal—New Service

W.O. #5561 DeFlice #815

Location JAN 22 1968

Date	Material	Amount	Total	Date	Amount
				11-2-67	150 20
				1-22-68	28 25
10/19/67	Labor	71 08			121 95
	10% O.H.	<u>7 11</u>	78 18		
	15' - 6" Transite Pipe @ .88		13 20		
	1 - 90° Elbow		4 09		
	1 - 6" Plug		3 80		
	1/2 - Bag cement @ 1.55		78		
	1 - 6" Saddle		5 50		
	1/2 - Ton hot top @ 5.80		2 90		
	1 - Hr. shovel @ 6.50		6 50		
	1 - Hr. Trucking		3 00		
	1/2 - Hr. compressor @ 5.00		2 50		
	1/2 - Hr. roller @ 3.00		<u>1 50</u>		
			121 95		
11-20-67	55' 6" Transite pipe				
H.B.M.18501	10' 4" Cast Iron pipe				


Deposit  
Retained

DATE \_\_\_\_\_

**TOWN OF LEXINGTON — BOARD OF PUBLIC WORKS**  
**SEWER DIVISION**

Sketch of Service Here

521

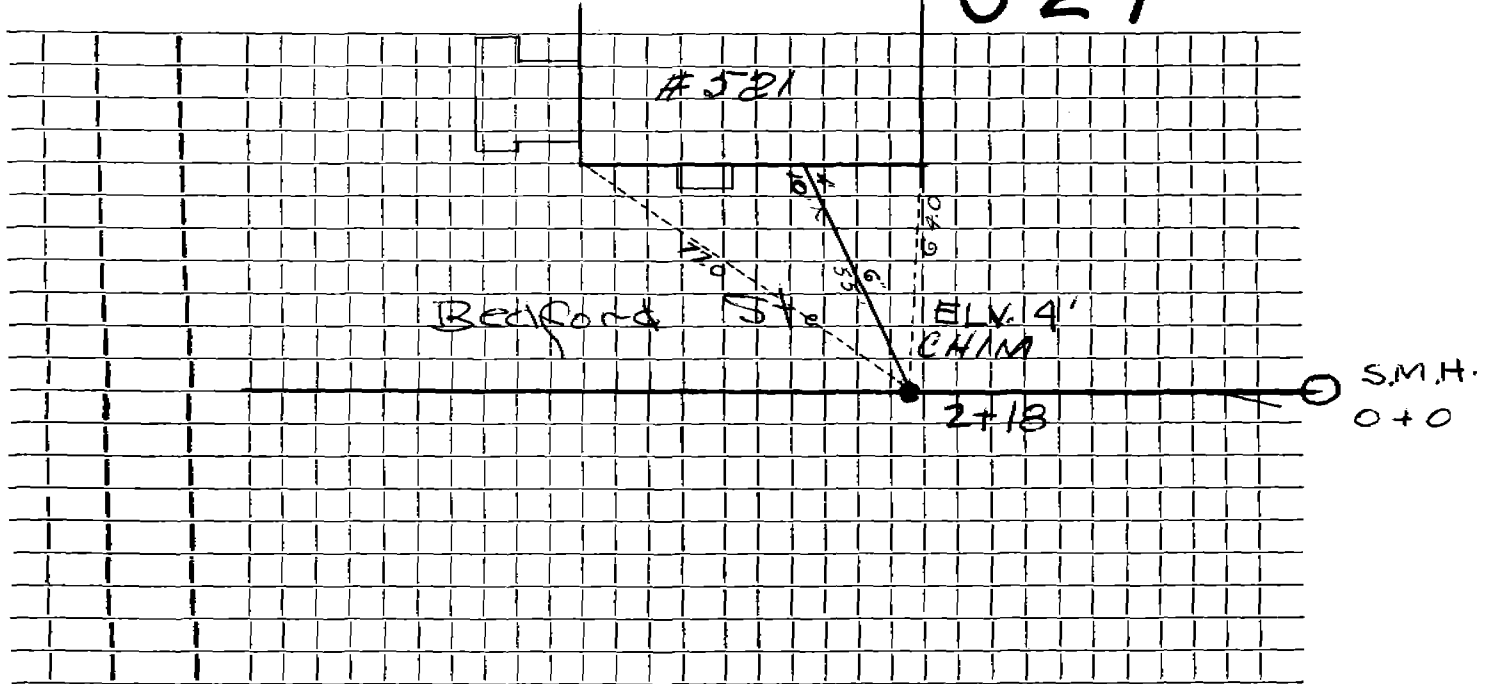

Connection made in ..... Street. Work completed .....

Remarks: .....  
.....  
.....