


DATE 1/5/94

TOWN OF LEXINGTON — BOARD OF PUBLIC WORKS
SEWER DIVISION

Sketch of Service Here 533

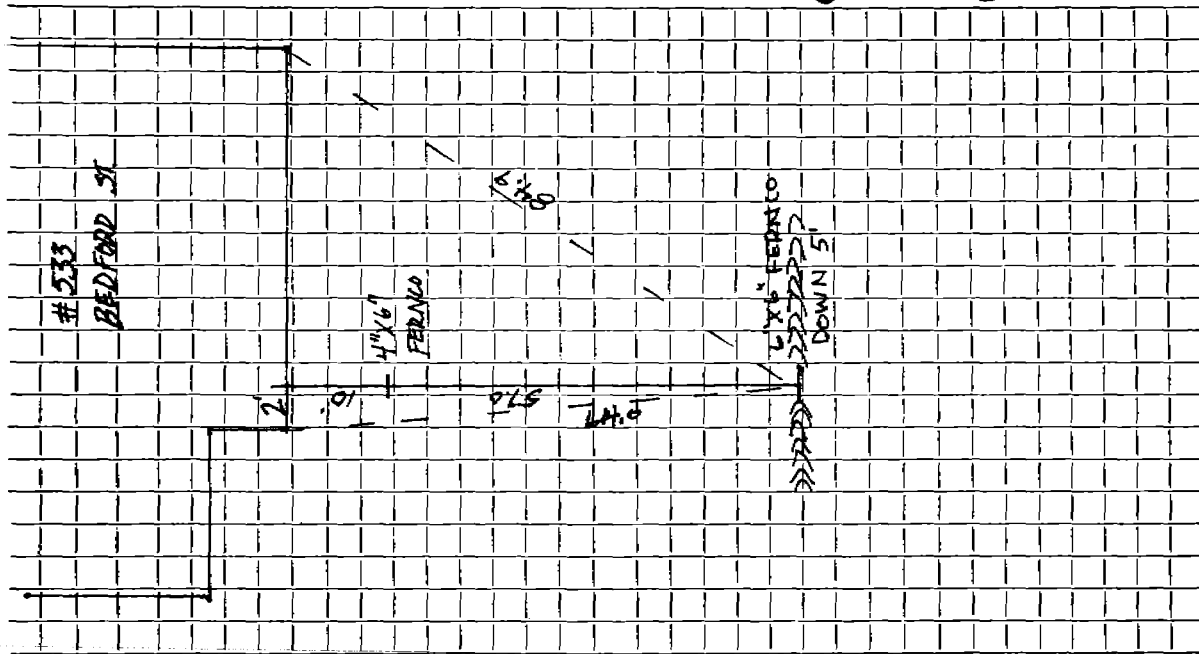

Connection made in Street.

Work completed ..10/20/93..... GRANESE.....

Remarks:
.....
.....