

Name M. S. Harrington

Service No. 4 60

Address 5 Harrington Road
54 Bedford St.

Location 54 Bedford Street

Kind of Pipe

Size

Size of Main

~~Repair~~ ~~Renewal~~ New Service

Location

Date	Material	Amount	Total	Date	Amount
Apr. 31, '44	Labor	2 10		April 21 '44	100 00
22	"	7 85		June 1 '44	31 26
24	"	13 60	23 55		68 74
	10% Overhead		2 36		
	Compressor - 1 hr. @ 1.75		1 75		
	Trucking - 2 hrs. @ .75		1 50		
	14 ' 6" V.C. Pipe @ .22		3 08		
	5 ' 4" Soil Pipe @ .50		2 50		
	Jointing Compound		1 00		
	22' laid in 1916 add		33 00		
			68 74		
	Labor				

Hadley Press, Inc., Lexington

TOWN OF LEXINGTON—BOARD OF PUBLIC WORKS
SEWER DIVISION

DATE _____

NO. _____

The undersigned applies for the construction of a particular sewer connecting No. _____ Street and hereby agrees to comply with the Rules and Regulations governing the construction and use of Particular Sewers, as now or at any future time established by the Board of Selectmen.


Am't. of Estimate \$ _____

Am't. Paid \$ _____

Owner

Sketch of Service Here

54

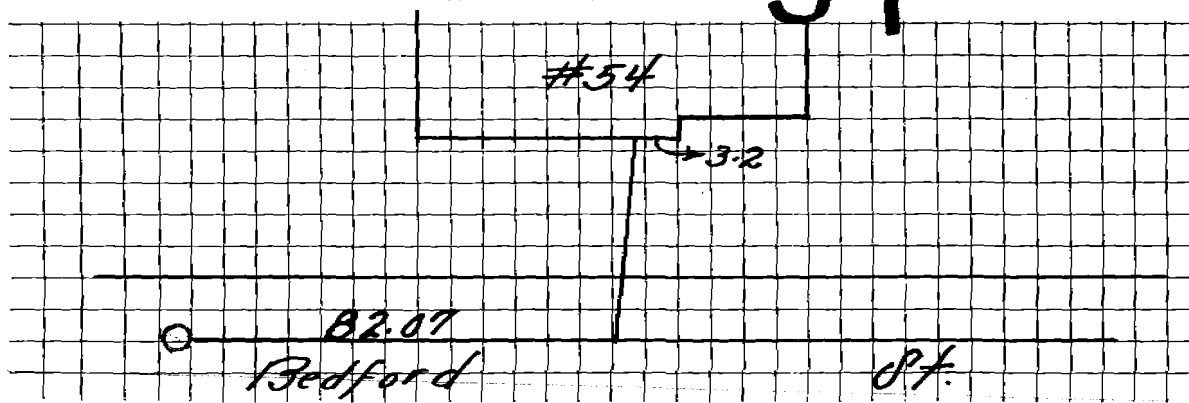

Connection made in _____ Street.

Work completed _____ 19

Remarks:

Name Custance Bros.
Address 54 Bedford Street

Service No. ~~7~~ 933

Location Winthrop F. Potter
Summit Road #25

Kind of Pipe Size Size of Main

~~Repair~~ ~~Renewal~~ New Service

Location

Date	Material	Amount	Total	Date	Amount
6/10/33	6" Sewer Pipe @.15	13 50			
Com for 16.80 on 7-19-33	Sulphur & Jute Trucking	5 40 75			
40	Hrs.Labor @.55	22 00	Cost to town		
6	" " @.60	3 60	\$45 25	June 8 1933 - Cash	16 80
	Charge to Custance				
38	6" Sewer Pipe @.15	5 70			
	Sulphur & Jute	2 88			
	Labor & Overhead	9 22	\$16 80		
	Labor			1-13-68 roots	

TOWN OF LEXINGTON—BOARD OF PUBLIC WORKS

SEWER DIVISION

DATE

June 7, 1933

NO.

Summit Rd

The undersigned applies for the construction of a particular sewer connecting No. Summit Rd Street and hereby agrees to comply with the Rules and Regulations governing the construction and use of Particular Sewers, as now or at any future time established by the Board of Selectmen.

Am't. of Estimate \$ 2280

Am't. Paid \$ _____


Oron W. Winthrop & P. P. Potter

Richard B. King
by J. A. Custard

Owner

Sketch of Service Here

54

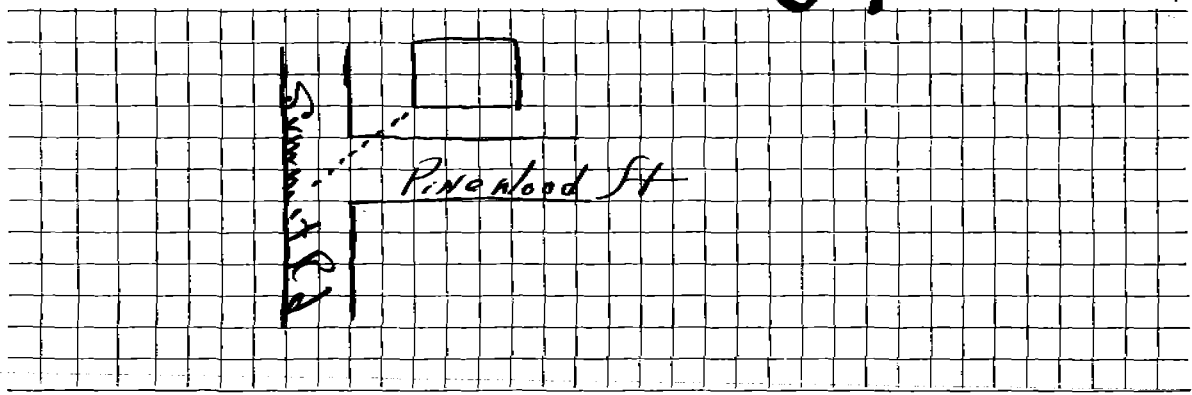

Connection made in _____ Street.

Work completed _____ 19

Remarks:

Water + Sewer in same trench
Exc. by contractor