


DATE 6/15/95

TOWN OF LEXINGTON — BOARD OF PUBLIC WORKS
SEWER DIVISION

Sketch of Service Here

560

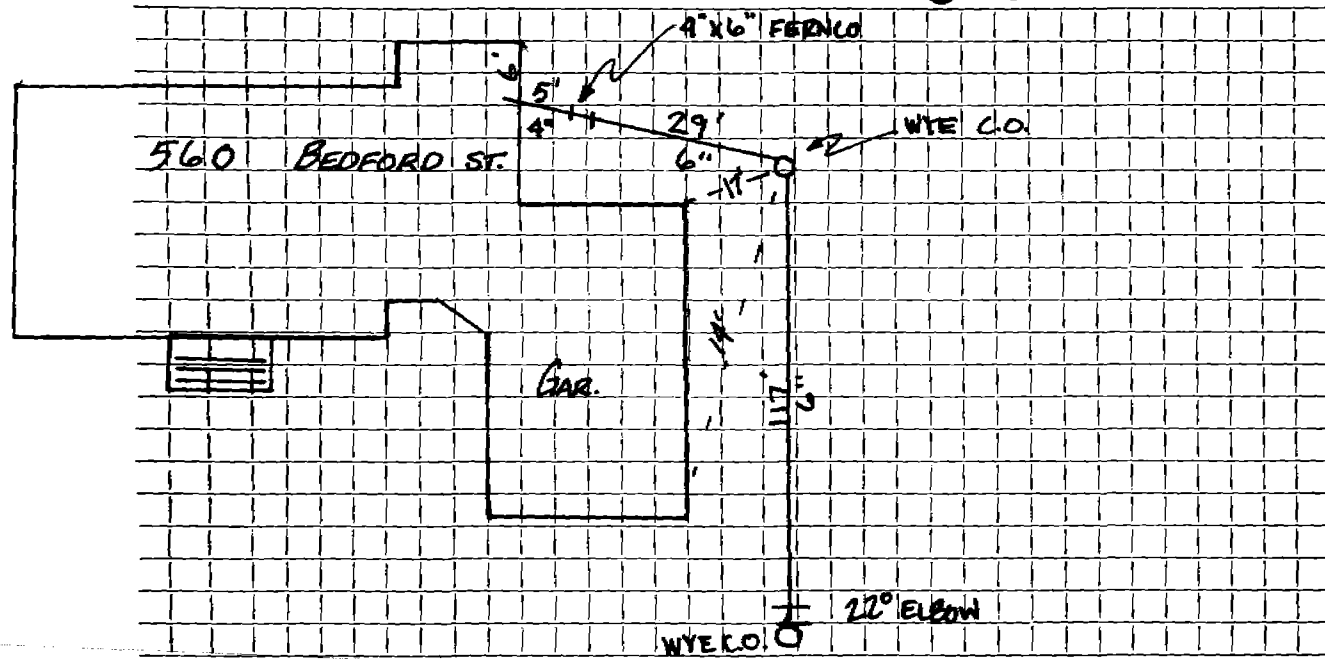

Connection made in BEDFORD ST. Street.

Work completed GAYLOR INC.

Remarks:

.....

.....