

Name Friendly Ice-Cream

Service No. 92

Address 66 Bedford St.

Location

Kind of Pipe

Size

Size of Main

Repair—Renewal—New Service

W.O. # 6802 Owen Clifford # 1478

Location DEC 22 1969


Date	Material	Amount	Total	Date	Amount
9/29/69	Labor	137 92		9-3-69	500 00
10/15/69	"	27 28		12-33-69	174 27
10/15/69	"	19 05	184 25		325 23
	10' C.H.		18 43		
	35' 6" Transite pipe .88		30 80		
	1' 10" Clay pipe		12 90		
	1' 10x6 Tee				
	1 11 1/2 Bend		4 09		
	1 Bag cement		1 55		
	1 Ton cold patch		5 85		
	3 Ton hot top 5.85		17 55		
	4 Hrs. trucking 3.00		12 00		
	1 " "		1 50		
	2 " shovel 6.50		13 00		
	2 " compressor 5.00		10 00		
	2 " loader 4.00		8 00		
	1 " roller		3 00		
	trailer		2 00		
			325 73		
10-7-69	22' 6" Transite pipe				
H.B.M. 18501	9' 4" Cast Iron pipe				

DATE _____

TOWN OF LEXINGTON — BOARD OF PUBLIC WORKS
SEWER DIVISION

Sketch of Service Here

66

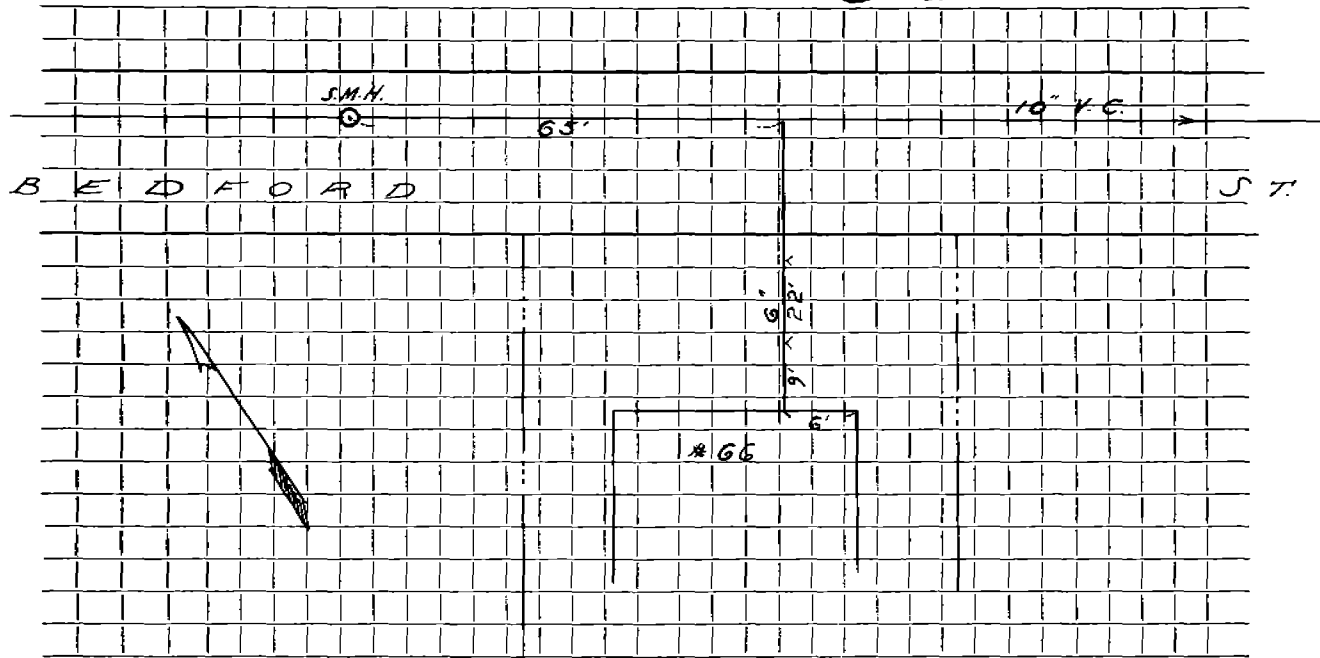

Connection made in Street. Work completed

Remarks:

.....
.....