

Name

Service No. 62

Address

68 Bedford St.

SEWER

Location

68 Bedford Street

Kind of Pipe

Size

Size of Main

Repair—Renewal—New Service

Location

Date

Material

Amount

Total

Date

Amount

See Back of Card


Plugged 6-13-86

Labor

68

New
Build

Town Down
#68

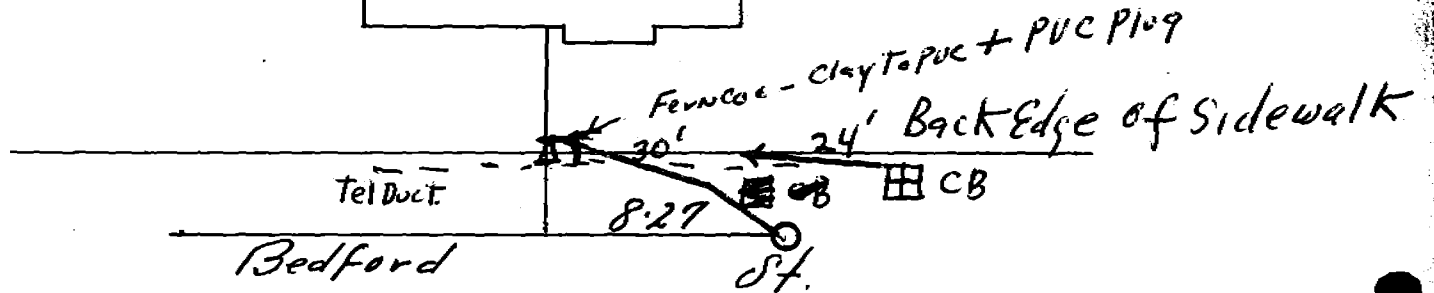

END SEWER 30' From M.H.