


DATE _____

TOWN OF LEXINGTON — BOARD OF PUBLIC WORKS
SEWER DIVISION

Sketch of Service Here **74 + 76**

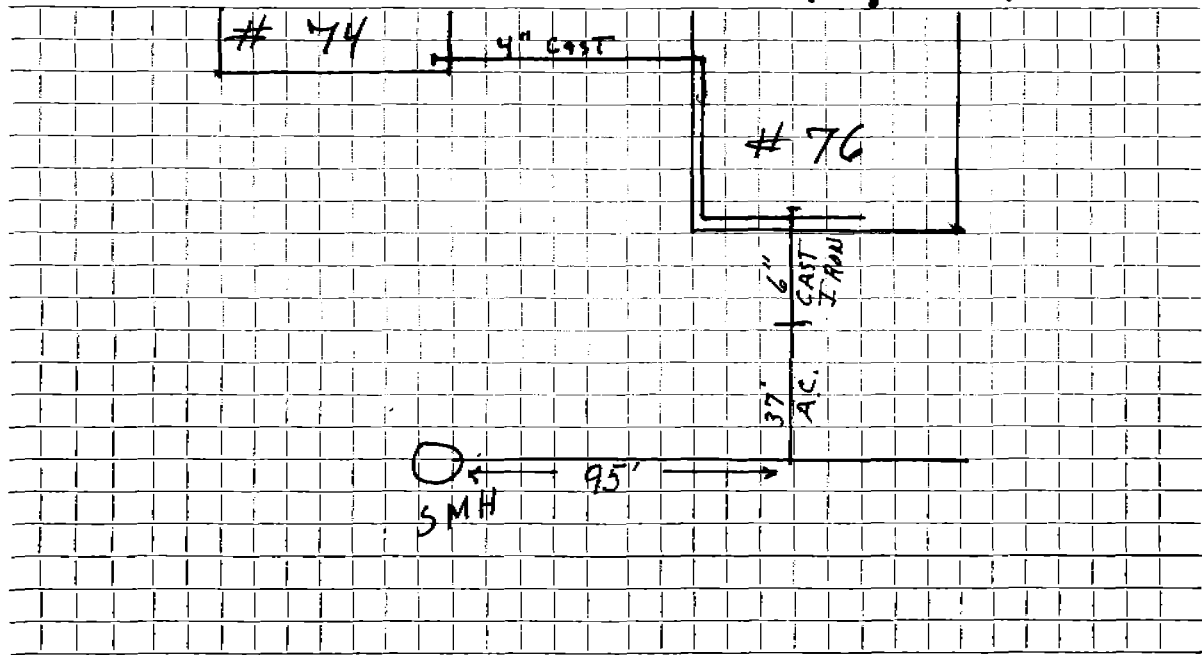

Connection made in Bedford ST Street. Work completed

Remarks: NOT INSPECTED BY WJ SEWER DEPT.

No. 74 Sewer Feeds Thru's 76.