




DATE \_\_\_\_\_

TOWN OF LEXINGTON — BOARD OF PUBLIC WORKS  
SEWER DIVISION

Sketch of Service Here

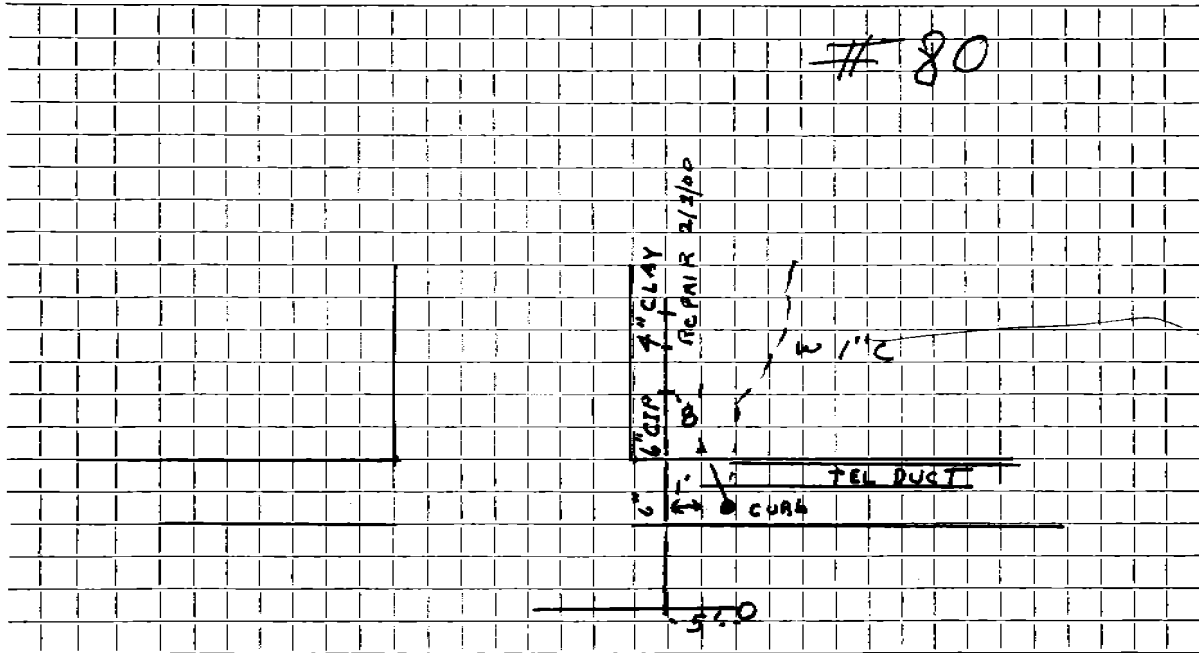

Connection made in ..... Street. Work completed .....

Remarks: Original 2 1/2" Service 9-13-27

... WATER + SEWER TOGETHER FROM BEHIND SIDEWALK OUT TO MAIN SAME DEPTH ABOUT 4'  
... 1' APART.

Name James McCarthy

Service No. 15 66

Address 80 Bedford Street

Location Same

Kind of Pipe

Size

Size of Main

~~Repair - Renewal~~ - New Service

Location

Date

Material

Amount

Total

Date

Amount

1935

June 12

10 hrs. @ 50¢

5 00

July 19 1935

7c

20 00

20 " @ 55¢

11 00

Jan 28 1936

13 20

12 " @ 60¢

7 20

33 70

20' 6" C.L. Pipe @ 10¢

2 00

8' 6" Sewer " @ 15¢

1 20

1 1/8" Bend

1 80

Sulphur & Jute

1 00

Trucking 3 hrs. @ \$1.50

4 50

33 70

Labor

4/6 80  
2/1/00

Roots 165' out  
Roots behind sidewalk  
Clearway cleaned while Pipe was  
OPENED UP by McMahon

TOWN OF LEXINGTON—BOARD OF PUBLIC WORKS  
SEWER DIVISION

DATE \_\_\_\_\_

NO. 10

The undersigned applies for the construction of a particular sewer connecting No. 80 Bedford ST.  
Street and hereby agrees to comply with the Rules and Regulations governing the construction and use of Particular  
Sewers, as now or at any future time established by the Board of Selectmen.


Am't. of Estimate \$ \_\_\_\_\_

Am't. Paid \$ \_\_\_\_\_

\_\_\_\_\_ Owner

Sketch of Service Here

80

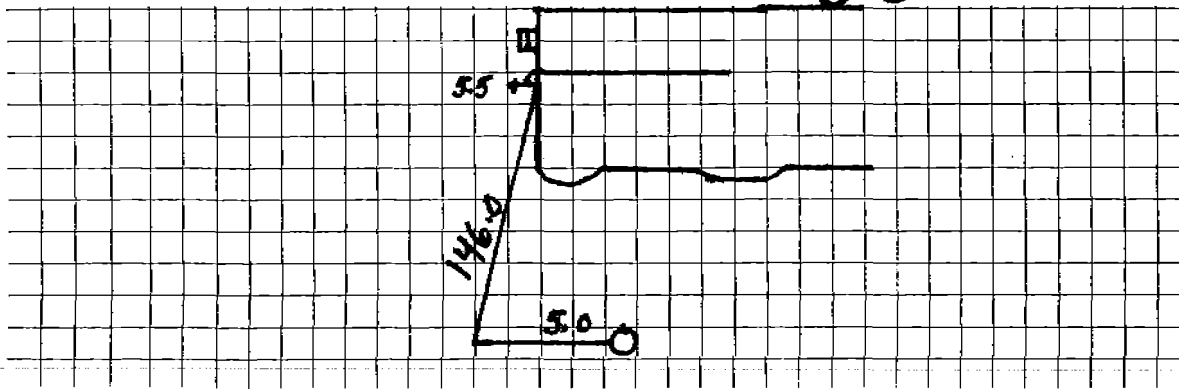

Connection made in \_\_\_\_\_ Street.

Work completed \_\_\_\_\_ 19

Remarks: