

Name Florence E. Edwards

Service No. 32 68

Address 81-23  
59 Bedford St.

Location

Kind of Pipe

Size

Size of Main

~~Repair - Renewal~~ - New Service

Location

Date	Material	Amount	Total	Date	Amount
11/21/32	38' 6" Sewer Pipe @ .15	5 70			
P. 12-31-32	10' 4" Iron " @ .50	5 00		Feb. 9 1933 - Cash	52 11
	1 6" Reducer	70			
	2 6" Bends @ .70	1 40			
	Sulphur & Jute	1 52			
Compressor,	2 Hrs. Drill. @ 3.00	6 00			
	7 St. Dyn. @ .25	1 75			
	12 Caps. @ .16	1 92			
	Trucking	75	\$24 74		
	40 Hrs. Labor @ .55	22 00			
3	" " @ .60	1 80	23 80		
	Labor, 15% overhead on		3 57		
			52 11		

Hadley Press, Inc., Lexington

TOWN OF LEXINGTON—BOARD OF PUBLIC WORKS  
**SEWER DIVISION**

DATE \_\_\_\_\_

NO. \_\_\_\_\_


The undersigned applies for the construction of a particular sewer connecting No. \_\_\_\_\_  
Street and hereby agrees to comply with the Rules and Regulations governing the construction and use of Particular  
Sewers, as now or at any future time established by the Board of Selectmen.

Am't. of Estimate \$ \_\_\_\_\_

Am't. Paid \$ \_\_\_\_\_

\_\_\_\_\_ Owner

Sketch of Service Here

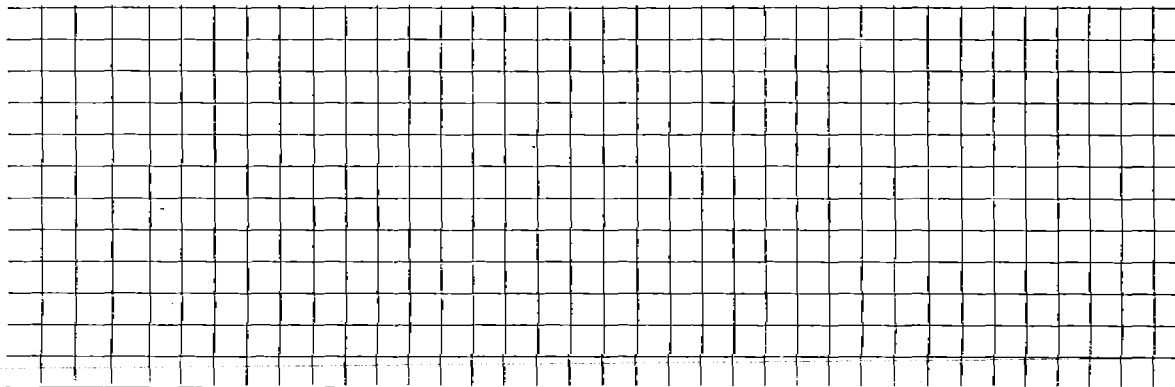

Connection made in \_\_\_\_\_ Street.

Work completed \_\_\_\_\_ 19

Remarks: