




DATE \_\_\_\_\_

TOWN OF LEXINGTON — BOARD OF PUBLIC WORKS  
SEWER DIVISION

Sketch of Service Here

88

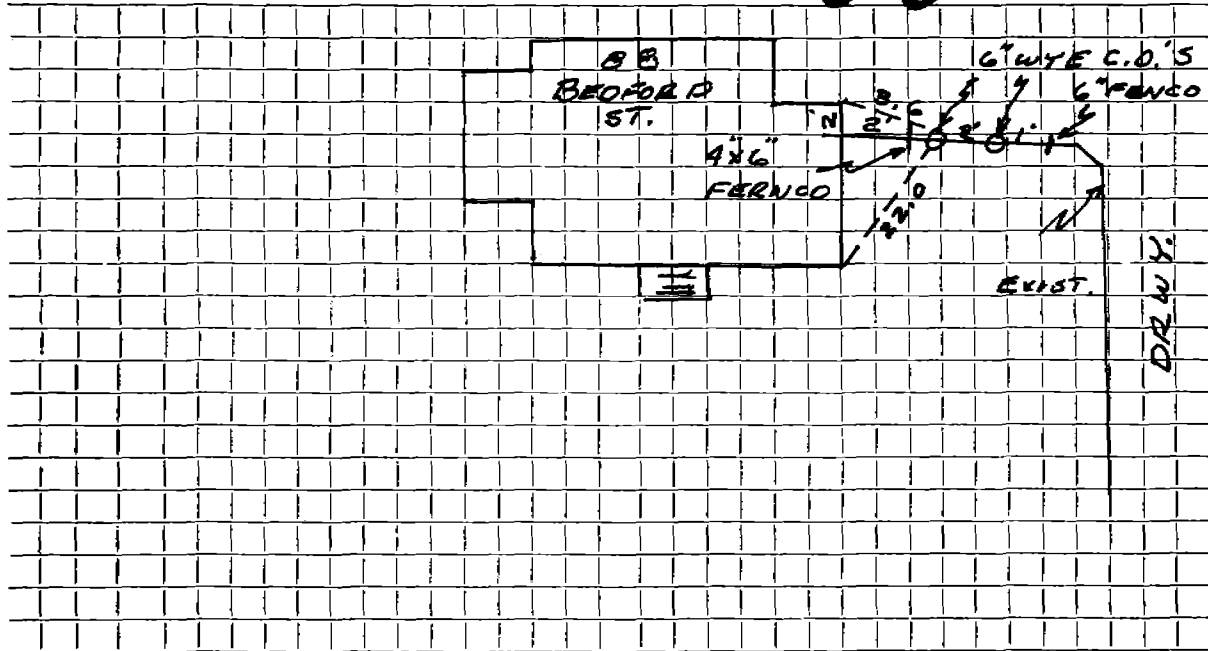

Connection made in BEDFORD Street. Work completed .....

Remarks: 2 WYE C.O.'S (NO CLEANOUT ON INSIDE) Original Service 5-8-35