

Name Edward A. Plugis

89 + 91 Also 93 + 95 Service No. 2 70

Address Woburn, R.F.D.
89 Bedford St.

Location 89 Bedford Street

Kind of Pipe

Size

Size of Main

~~Repair~~ ~~Renewal~~ — New Service

Location

Date	Material	Amount	Total	Date	Amount
2/25/42	23 hrs. @ 55¢	12 65		February 3, 1942	Deposited 205.00
Com 4/6/42	109½ " @ 60¢	67 70		April 17, 1942	Credit from acct. # 5 15.47
	46 " @ 65¢	29 90			20.60
	3½ " @ 70¢	2 45			
	21 " @ 75¢	15 75	128 45	July 31, 1942	59.61
	10% Overhead		12 85		300.68
	Labor-building manhold(Dacey)		4 00		
	36' 6" Sewer Pipe @ 16¢		5 76		
	96' 8" " " @ 20¢		19 20		
	Joint.compound		7 92		
	1 Manhole cover & frame		4 00		
	500 Brick		8 75		
	5 bags cement @ 68¢		3 40		
	1½ Tons #5 Mason's sand		1 35		
	12 loads gravel @ 50¢		6 00		
	33 hrs. compressor @ 2.25		74 25		
	Labor 25 hrs. trucking @ 75¢		18 75		
	Trench repairs		6 00		
			300 68		

TOWN OF LEXINGTON—BOARD OF PUBLIC WORKS
SEWER DIVISION

DATE 7-2-1942


NO. _____

The undersigned applies for the construction of a particular sewer connecting No. 89 Bedford Street and hereby agrees to comply with the Rules and Regulations governing the construction and use of Particular Sewers, as now or at any future time established by the Board of Selectmen.

Am't. of Estimate \$ _____

Am't. Paid \$ _____

Edward A. Puzio Owner

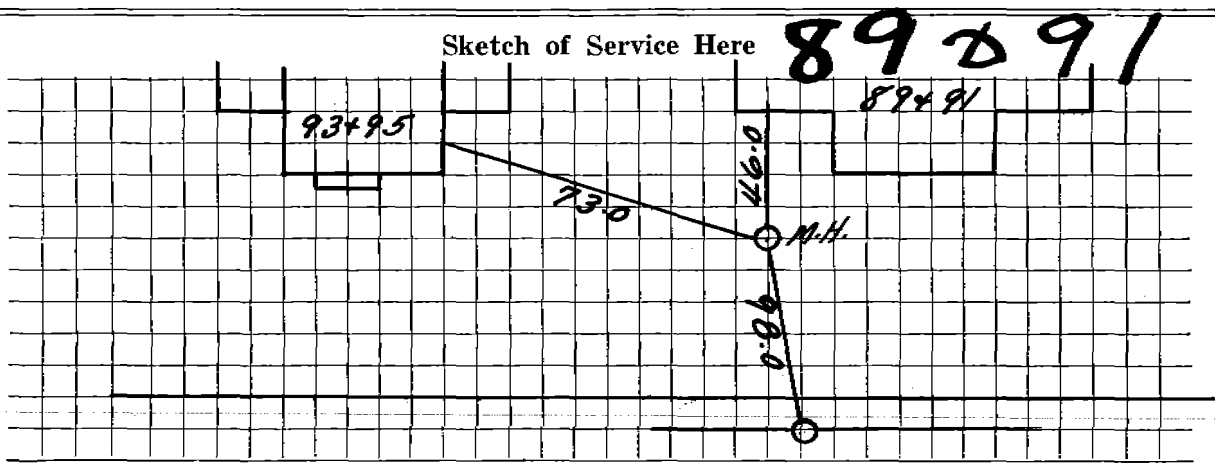

Connection made in _____ Street.

Work completed _____ 19

Remarks: