

Name Mr. Patrick J. Maguire
 Address ⁹²~~66~~ Bedford St.

Service No. 10 72

Location

Kind of Pipe

Size

Size of Main

~~Repair~~ ~~Renewal~~ New Service

Location

Date	Material	Amount	Total	Date	Amount
8/3/33	50' 6" Sewer Pipe @.15	7 50			
⁹⁻¹⁹⁻³³ 1	6" Ell	70			
1	6" Y	70			
	Sulphur & Jute	2 00			
	Trucking	75	11 65		
14	Hrs. Labor @.60	8 40			
2	" " @.55	1 10	9 50		
	15% Overhead		1 43		
			\$22 58	Feb. 24 1934	22 58
	Labor				
				11-23-64	SLUDGE
				11-28-66	SLUDGE
				1-19-67	
				12-30-70	Plugged Sludges & Roots

Hadley Press, Inc., Lexington

TOWN OF LEXINGTON—BOARD OF PUBLIC WORKS

SEWER DIVISION

DATE Aug 2nd 1933

NO. _____


The undersigned applies for the construction of a particular sewer connecting No. _____ Street and hereby agrees to comply with the Rules and Regulations governing the construction and use of Particular Sewers, as now or at any future time established by the Board of Selectmen.

Am't. of Estimate \$ _____

Am't. Paid \$ _____

Patrick J. Maguire Owner

Sketch of Service Here **92**

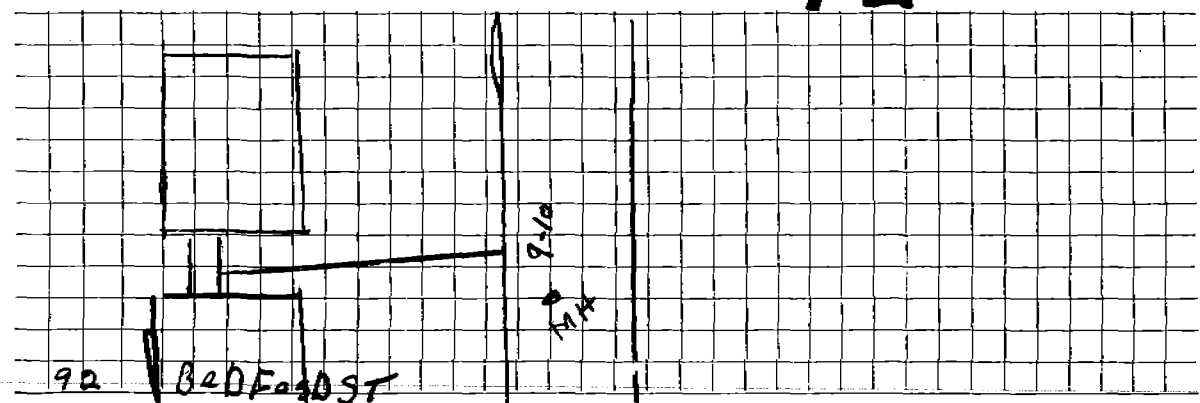

Connection made in _____ Street.

(Work completed) _____ 19

Remarks:

8/10/33

8/10/33